

CITY AND COUNTY OF DENVER

DEPARTMENT OF TRANSPORTATION AND INFRASTRUCTURE - TRANSPORTATION DESIGN

2021 PEDESTRIAN PROGRAM INTERSECTION IMPROVEMENTS
MASTER CONTRACT NO. OC201631677
TASK ORDER NO. 15
CITY MASTER PROJECT NUMBER PRJ-10002820/31050/5011000

FINAL PLANS

JULY 2022

INDEX OF SHEETS

SHEET NO.	TITLE
1	TITLE SHEET
2 - 4	GENERAL NOTES
5	SUMMARY OF APPROXIMATE QUANTITIES
6	SIGN SCHEDULE
7 - 10	ALAMEDA AVENUE & FRANKLIN STREET
11 - 14	E. MISSISSIPPI AVENUE & S. DOWNING STREET
15 - 17	OSAGE STREET CHARTER SCHOOL CROSSING
18 - 21	WOLFF STREET & W. 17TH STREET (TO BE CONSTRUCTED BY OTHERS)
22 - 24	DETAIL SHEETS


Design and quality adjustments on sheets
1,5,6,9,11,12,13,14,15,16,17,18,19,20,21

All revisions by Rachael Vigil. PE, 6/16/2025

Note: Plan Revisions have been reviewed and approved by DOTI, Engineer of Record did not review or approve revisions.

CITY AND COUNTY OF DENVER
DEPARTMENT OF TRANSPORTATION
AND INFRASTRUCTURE

APPROVED BY:	
DIRECTOR OF DOTI:	DATE
CITY ENGINEER:	DATE
DIRECTOR OF ENGINEERING CAPITAL PROJECTS:	DATE
CITY TRAFFIC ENGINEER:	DATE

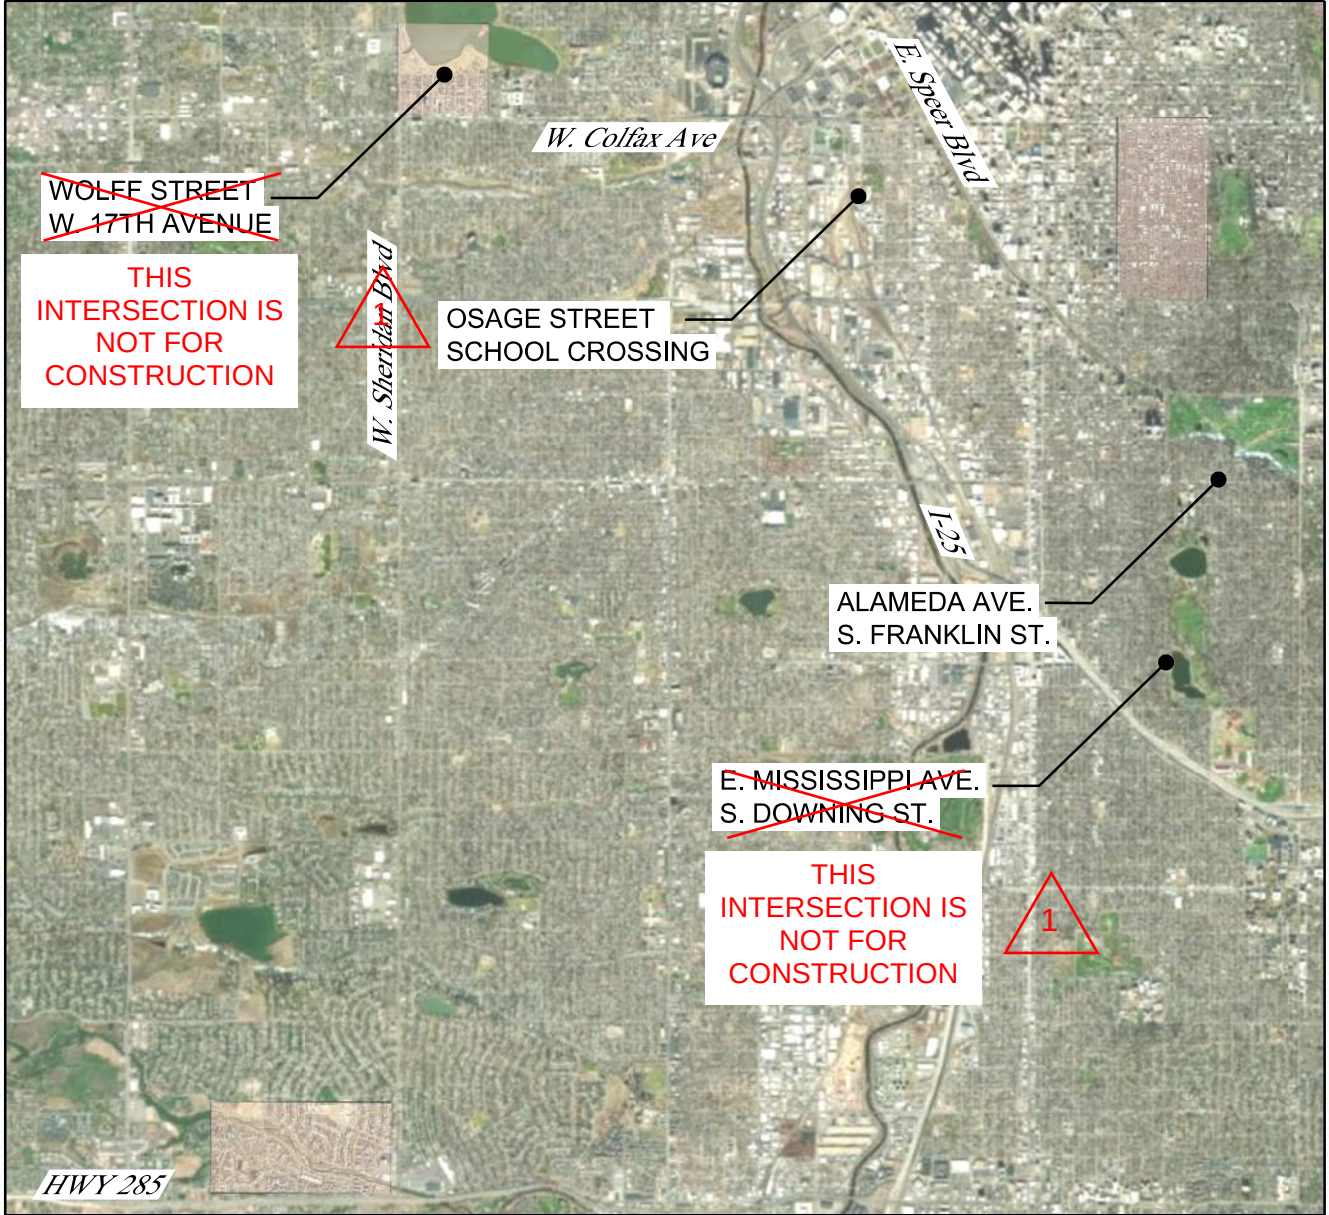

PROJECT LOCATION MAP



alison 9:31:28 AM P:\2020 Projects\20-005\01 Ped Intersection Program Development\20005\Traffic_ITS\Drawings\Alameda-Mississippi-Osage-Wolff Plan Package\20005_SS4TRAF_Title_July 2021.dgn
CDOT V81 Signals.tbl

Print Date: 7/18/2022		0000	Sheet Revisions				As Constructed		TITLE SHEET				
Drawing File Name: 20005_SS4TRAF_Title_July 2021.dgn			Date:	Comments	Init.		No Revisions:						
Horiz. Scale: 1:1							Revised:		Designer:	AJL	Structure Numbers		Sheet Number 1
Vert. Scale: As Noted							Void:		Detailer:	MAB			
							Sheet Subset: TITLE		Subset Sheets: 1 of 1				

\\s110115\3 AM P\2020 Projects\2005.01 Ped Intersection Program Development\2005\Traffic_ITS\Drawings\Alameda-Mississippi-Osage-Wolff Plan Package\2005_SS4TRAF_General Notes.dgn
6/6/2022 CDOT-DefaultPrinter_Vblptf6g MEC-Standard.tbl

GENERAL

1. THE CONTRACTOR SHALL LIMIT CONSTRUCTION ACTIVITIES TO THOSE AREAS WITHIN THE LIMITS OF DISTURBANCE AS SHOWN ON THE PLANS. ANY DISTURBANCE BEYOND THESE LIMITS SHALL BE RESTORED TO THE ORIGINAL CONDITION BY THE CONTRACTOR AT ITS OWN EXPENSE. CONSTRUCTION ACTIVITIES. IN ADDITION TO NORMAL CONSTRUCTION PROCEDURES, WHICH ALTER THE EXISTING CONDITIONS.
2. THE CONTRACTOR SHALL PROTECT ALL WORK AREAS AND FACILITIES FROM WATER INTRUSION AT ALL TIMES. AREAS AND FACILITIES SUBJECTED TO FLOODING, REGARDLESS OF THE SOURCE OF WATER, SHALL BE PROMPTLY DEWATERED AT NO COST TO THE CITY.
3. ALL WORK SHALL CONFORM TO CITY AND COUNTY OF DENVER STANDARDS AND SPECIFICATIONS. THE CITY RESERVES THE RIGHT TO ACCEPT OR REJECT ANY MATERIALS AND WORKMANSHIP THAT DOES NOT CONFORM OR HALT CONSTRUCTION UNTIL CONFLICT IS RESOLVED.
4. ALL STORM DRAIN INLETS, LATERALS, MAINS AND OTHER STORM RUNOFF APPURTENANCES WITHIN THE PROJECT LIMITS SHALL BE CLEARED OF SEDIMENT AND DEBRIS IN ACCORDANCE WITH DENVER WASTE WATER MANAGEMENT DEPARTMENT STANDARDS BEFORE THE COMMENCEMENT OF CONSTRUCTION. ANY SEDIMENT AND/OR DEBRIS REMAINING IN THE STORM SEWER SYSTEM AFTER CONSTRUCTION SHALL BE REMOVED BY THE CONTRACTOR AT NO COST TO THE CITY.
5. ALL STRIPING THAT CONFLICTS WITH PROPOSED STRIPING SHOULD BE REMOVED.
6. COMPLETE COORDINATION SHALL BE MAINTAINED WITH THE CITY ENGINEER.
7. CONTRACTOR IS RESPONSIBLE FOR REMOVING, RELOCATING OR REPAIRING ANY EXISTING IRRIGATION ITEMS THAT HAVE BEEN DAMAGED DURING CONSTRUCTION OR IMPACTED WITHIN THE PROJECT LIMITS.
8. CONTRACTOR IS RESPONSIBLE FOR BEING AWARE OF, NOTIFYING, COORDINATION AND SCHEDULING ALL INSPECTIONS REQUIRED FOR FINAL APPROVALS AND PROJECT ACCEPTANCE.
9. ALL WORK AREAS SHALL BE PROPERLY PROTECTED PRIOR TO THE END OF WORK DAY; NO OPEN HOLES ARE ALLOWED OVERNIGHT. ALL WORK IS TO BE IN ACCORDANCE WITH APPLICABLE STANDARDS.
10. NO CLEATED OR TRACKED EQUIPMENT MAY WORK IN OR MOVE OVER PAVED SURFACES WITHOUT MATS.
11. IN THE EVENT THAT AN EMERGENCY REPAIR TO EXISTING FACILITIES IS NECESSARY, THE CITY INSPECTOR SHALL IMMEDIATELY BE NOTIFIED OF POSSIBLE TRAFFIC HAZARDS. EMERGENCY PROCEDURES SHALL BE COORDINATED BEFOREHAND, WHERE POSSIBLE, NO WORK WILL BE ALLOWED UNTIL NOTIFICATION IS RECEIVED. EMERGENCY TELEPHONE NOTIFICATION MUST BE FOLLOWED UP WITH A LETTER AS SOON AS POSSIBLE.
12. ALL MATERIALS AND WORKMANSHIP SHALL BE SUBJECT TO INSPECTION BY THE CITY. THE CITY RESERVES THE RIGHT TO ACCEPT OR REJECT ANY MATERIALS AND WORKMANSHIP THAT DOES NOT CONFORM TO THE CITY AND COUNTY STANDARDS AND CDOT STANDARD SPECIFICATIONS, LATEST EDITION.
13. PRIOR TO FINAL ACCEPTANCE, ALL DISTURBED PORTIONS OF THE CITY RIGHT-OF-WAY SHALL BE CLEANED AND RESTORED TO THE ORIGINAL CONDITION, SUBJECT TO CITY APPROVAL.
14. THE CONTRACTOR SHOULD REMOVE MATERIALS AND EQUIPMENT FROM THE ROADWAY ROW AT THE CLOSE OF DAILY OPERATIONS. THE TRAFFIC CONTROL PLAN (TCP) MUST INCLUDE PROTECTIVE MEASURES WHERE MATERIALS AND EQUIPMENT MAY BE STORED IN THE ROW, BUT ENSURE FIVE FEET OF PEDESTRIAN CLEARANCE ON SIDEWALKS. THE CONTRACTOR SHALL NOT STOCKPILE MATERIAL IN THE CLEAR ZONE OF THE TRAVELED WAY.
15. THE CONTRACTOR IS RESPONSIBLE FOR OBTAINING ALL PROJECT PERMITS ASSOCIATED WITH CONSTRUCTION. THE CONTRACTOR IS RESPONSIBLE FOR BEING AWARE OF, NOTIFYING, COORDINATING AND SCHEDULING ALL INSPECTIONS REQUIRED FOR FINAL APPROVALS AND PROJECT ACCEPTANCE. ALL WORK, INCLUDING CORRECTION WORK, IS SUBJECT TO NOTIFICATION AND INSPECTION REQUIREMENTS.
16. IF ANY OF THE CONTRACTOR’S OPERATIONS DESTROY OR DAMAGE ANY PROPERTY. PUBLIC OR PRIVATE, THE CONTRACTOR SHALL PROMPTLY REPAIR OR REPLACE SUCH PROPERTY, TO THE SATISFACTION OF THE PROJECT MANAGER, BEFORE THE CITY WILL ACCEPT OR PAY FOR THE WORK PERFORMED UNDER THE CONTRACT. IF THE CONTRACTOR FAILS TO REPAIR OR REPLACE SUCH PROPERTY, THE CITY, AT THE SOLE DISCRETION OF THE MANAGER, MAY UNDERTAKE SUCH REPAIR OR REPLACEMENT AND DEDUCT THE COST OF THE SAME FROM AMOUNTS PAYABLE TO THE CONTRACTOR UNDER THE CONTRACT.
17. NO WORK SHALL BE PERMITTED ON WEEKENDS OR HOLIDAYS WITHOUT PRIOR AUTHORIZATION OR UNLESS OTHERWISE SPECIFIED. THE CITY MAY RESTRICT WORK IN THE ROW DURING ADVERSE WEATHER CONDITIONS OR DURING PERIODS OF HIGH TRAFFIC VOLUME.
18. PROTECTION AND REPLACEMENT OF STREET IMPROVEMENTS ARE THE RESPONSIBILITY OF THE CONTRACTOR UNTIL THESE IMPROVEMENTS ARE FULLY COMPLETED AND ACCEPTED BY THE CITY.

19. ALL PAVEMENT MARKINGS SHALL BE INSTALLED ON A CLEAN SURFACE, AS CALLED FOR BY THE RESPECTIVE MANUFACTURERS. SURFACE CLEANING BY POWER WASH SHALL ALSO BE REQUIRED WHEN THERE IS A POSSIBILITY OF DEICING MATERIAL ON THE ROAD. BEFORE APPLYING NEW PAVEMENT MARKINGS THE CONTRACTOR MUST REMOVE 80% OF THE OLD MARKINGS. IT IS THE CONTRACTOR'S RESPONSIBILITY TO USE ANY MEANS NECESSARY TO ENSURE APPROPRIATE SURFACE PREPARATION OF THE SURFACE SHALL BE INCLUDED IN THE COST OF THE MATERIAL PRIOR TO THE PAVEMENT BEING PREPARED FOR STRIPING. THE CONTRACTOR SHALL REVIEW SECTION 107.25 AND ALL OF SECTION 208, IN THE LATEST VERSION OF THE CDOT STANDARD SPECIFICATIONS BOOK.

PROJECT PLANS, SPECIFICATIONS, PERMITS

1. ALL MATERIAL, EQUIPMENT, INSTALLATION AND CONSTRUCTION WITHIN THE ROW SHALL BE IN ACCORDANCE WITH THE LATEST EDITION OF THE FOLLOWING STANDARD REFERENCES AS APPLICABLE:

1.a. CITY AND COUNTY OF DENVER, STANDARDS AND DETAILS FOR ENGINEERING DIVISION

1.b. DEPARTMENT OF TRANSPORTATION & INFRASTRUCTURE STANDARD SPECIFICATIONS FOR CONSTRUCTION GENERAL CONTRACT CONDITIONS

1.c. TRAFFIC STANDARD DRAWINGS AND TRANSPORTATION AND MOBILITY PROJECT SPECIALS

1.d. FEDERAL HIGHWAY ADMINISTRATION (FHWA) MANUAL ON UNIFORM TRAFFIC CONTROL DEVICES (MUTCD) FOR STREETS AND HIGHWAYS AND THE COLORADO SUPPLEMENT THERETO

1.e. AMERICAN ASSOCIATION OF STATE HIGHWAY TRANSPORTATION OFFICIALS (AASHTO) ROADSIDE DESIGN GUIDE

1.f. DENVER BIKEWAY DESIGN MANUAL
2. THE CONTRACTOR SHALL HAVE ONSITE AT ALL TIMES, ONE COPY OF THE APPROVED PLANS, ONE COPY OF THE APPROPRIATE STANDARDS AND SPECIFICATIONS, AND COPIES OF ANY PERMITS AND EXTENSION AGREEMENTS NEEDED FOR THE JOB.
3. IF DURING THE CONSTRUCTION PROCESS, CONDITIONS ARE ENCOUNTERED WHICH COULD INDICATE A SITUATION THAT IS NOT IDENTIFIED ON THE PLANS OR SPECIFICATIONS, THE CONTRACTOR SHALL CALL THE PROJECT MANAGER IMMEDIATELY.
4. DIMENSIONS CONTAINED IN THESE PLANS ARE CALCULATED FROM THE AERIAL IMAGERY. THE CONTRACTOR SHALL VERIFY DEPENDENT DIMENSIONS IN THE FIELD AND SHALL VERIFY ALL INFORMATION AND CONDITIONS BEFORE BIDDING THE PROJECT, AND BEFORE ORDERING OR FABRICATING ANY MATERIAL.
5. ALL WORK SHALL CONFORM TO CURRENT CITY AND COUNTY OF DENVER STANDARDS AND SPECIFICATIONS. THE CITY RESERVES THE RIGHT TO ACCEPT OR REJECT ANY MATERIALS AND WORKMANSHIP THAT DOES NOT CONFORM TO THE LATEST EDITION OF THE CITY STANDARDS AND SPECIFICATIONS, OR HALT CONSTRUCTION UNTIL THE CONFLICT IS RESOLVED.

REMOVALS, EXISTING ITEMS

1. ALL ITEMS TO BE REMOVED AND NOT RESET SHALL BECOME THE PROPERTY OF THE CONTRACTOR AND SHALL BE REMOVED FROM THE SITE AND DISPOSED PROPERLY.
2. SIGNS DESIGNATED AS REMOVAL ITEMS SHALL BE CAREFULLY REMOVED AND DELIVERED BY THE CONTRACTOR TO THE CITY YARD AT 5440 ROSLYN STREET, BUILDING E. ANY MATERIAL DESIGNATED FOR SALVAGE THAT IS DAMAGED AFTER REMOVAL SHALL BE REPAIRED OR REPLACED BY THE CONTRACTOR TO THE SATISFACTION OF THE ENGINEER. NO SEPARATE PAYMENT SHALL BE MADE FOR LOADING, HAULING, UNLOADING, OR PLACING SALVAGED MATERIALS IN THE CITY YARD.

TRAFFIC

1. THE CONTRACTOR IS RESPONSIBLE FOR PROVIDING AND MAINTAINING ADEQUATE TRAFFIC CONTROL THROUGHOUT THE PROJECT, INCLUDING PROPER TRAFFIC CONTROL DEVICES AND PERSONNEL. A TRAFFIC CONTROL PLAN (TCP) IS SUBJECT TO CITY APPROVAL PRIOR TO COMMENCING WORK ON ROADWAY ROW. A COPY OF APPROVED TCPS MUST BE AVAILABLE ON SITE DURING WORK. TRAFFIC CONTROL IS TO BE IN ACCORDANCE WITH THE MANUAL ON UNIFORM TRAFFIC CONTROL DEVICES (MUTCD) AND CDOT M&S STANDARDS.
2. ALL PAVEMENT MARKINGS MUST BE INSTALLED ACCORDING TO MANUFACTURER'S SPECIFICATIONS.
3. PAVEMENT MARKING REMOVAL SHALL BE COMPLETED BY SANDBLASTING OR WATERBLASTING METHODS ONLY. GRINDING WILL ONLY BE ALLOWED WITH PRIOR APPROVAL FROM THE ENGINEER.



As Constructed	GENERAL NOTES				
No Revisions:					
Revised:	Designer:	AJL	Structure Numbers	Sheet Number	
	Detailer:	MAB			
Void:	Sheet Subset:	GN	Subset Sheets:	1 of 3	2



Print Date: 6/6/2022			Sheet Revisions		
Drawing File Name: 20005_SS4TRAF_General Notes.dgn			Date:	Comments	Init.
Horiz. Scale: 1:1					
Vert. Scale: As Noted					



alation 10:58:15 AM P:\2020 Projects\20005\01 Ped Intersection Program Development\20005\Traffic_ITS\Drawings\Alameda-Mississippi-Osage-Wolff Plan Package\20005_SS4TRAF_General Notes.dgn
6/13/2022 C:\OT-Default\Printer_Vblptf6g MEC-Standard.ttl

DENVER PARKS AND RECREATION NOTES:

*FOR ALL WORK OCCURRING ON LAND MANAGED AND OPERATED BY DENVER PARKS AND RECREATION (DPR).

1. THE CONTRACTOR SHALL OBTAIN A TEMPORARY CONSTRUCTION ACCESS PERMIT (TCAP) FOR ANY WORK OR OCCUPANCY OF PARK LAND. THIS INCLUDES BUT IS NOT LIMITED TO: DESIGNATED PARKS, PARKWAYS, OPEN SPACE, TRAILS, AND BIKE PATHS. INFORMATION AND APPLICATION CAN BE FOUND AT:
https://www.denvergov.org/Government/Agencies-Departments-Offices/Parks-Recreation/Planning-Development/Construction-Access-Permits
2. ALL WORK SHALL CONFORM TO THE DENVER PARKS AND RECREATION CURRENT CONSTRUCTION STANDARDS AND SPECIFICATIONS.
3. ANY DAMAGE TO LAND MANAGED AND OPERATED BY DPR, INCLUDING BUT NOT LIMITED TO, CONCRETE, IRRIGATION, LANDSCAPE, UTILITIES, FENCING, AND SITE AMENITIES SHALL BE RESTORED, REPAIRED, OR REPLACED TO DENVER PARKS AND RECREATION'S CURRENT STANDARDS AND SPECIFICATIONS AND ACCEPTED BY PARKS.
4. RESTORATION OF TURFGRASS SHALL BE DONE WITH TURFGRASS SOD, SEED IS NOT ALLOWED.
5. ALL LANDSCAPE AND IRRIGATION WORK/REPAIR SHALL BE PERFORMED BY A LANDSCAPE CONTRACTOR.
6. FOR PROJECTS WITH AUTOMATIC IRRIGATION CONTROLLERS: IF POWER FROM AN EXISTING LIGHT POLE IS PROVIDING ELECTRICAL SERVICE TO AN IRRIGATION CONTROLLER AND THE SERVICE IS INTERRUPTED, THE CONTRACTOR SHALL RESTORE POWER TO THE IRRIGATION CONTROLLER.

FORESTRY


OFFICE OF THE CITY FORESTER TREE PROTECTION NOTES:

1. EXISTING TREES TO BE PRESERVED IN PUBLIC RIGHT OF WAY SHALL BE PROTECTED PER OFFICE OF THE CITY FORESTER STANDARDS & PRACTICES. TREE PROTECTION SHALL BE INSTALLED PRIOR TO ISSUE OF DEMOLITION/BUILDING PERMIT, APPROVED BY THE OFFICE OF THE CITY FORESTER, AND SHALL REMAIN IN PLACE THROUGHOUT CONSTRUCTION. NO CONSTRUCTION ACTIVITIES OR STORAGE OF CONSTRUCTION MATERIALS/DEBRIS/EQUIPMENT SHALL TAKE PLACE WITHIN TREE PROTECTION ZONES WITHOUT PRIOR WRITTEN AUTHORIZATION FROM THE OFFICE OF THE CITY FORESTER. ALL CONSTRUCTION ACTIVITY MUST OCCUR OUTSIDE TREE PROTECTION ZONES (I.E DRIPLINES OF TREES).
2. IF PRUNING FOR CONSTRUCTION ACTIVITY IS NECESSARY, CONTRACTOR SHALL CONSULT WITH OFFICE OF THE CITY FORESTER STAFF PRIOR TO COMMENCEMENT OF WORK.
3. MINIMUM TREE PROTECTION REQUIREMENTS: TREE PROTECTION SHALL BE INSTALLED AT THE CRITICAL ROOT ZONE (CRZ). THE CRZ IS EQUAL TO THE DRIPLINE, FURTHEST EXTENT OF TREE CANOPY, OR IS EQUAL TO ONE FOOT RADIALLY FROM THE TREE FOR EVERY ONE INCH OF TRUNK DIAMETER AT BREAST HEIGHT (DBH = 4.5' ABOVE SOIL LINE), WHICHEVER IS GREATER.

a. FOR DEMOLITION ACTIVITIES: ORANGE PLASTIC SAFETY FENCING IS ACCEPTABLE. FENCING SHALL BE MIN. 48" IN HEIGHT, TOP SECURED TO METAL T-POSTS WITH 12-GAUGE WIRE WOVEN THROUGH TOP OF FENCING FOR ENTIRE LENGTH. HEAVY DUTY T-POSTS SHALL BE PLACED SO THAT WIRE & FENCE ARE TAUT.

b. FOR CONSTRUCTION ACTIVITIES: USE 6' CHAIN LINK FENCING TO ESTABLISH TREE PROTECTION ZONE (TPZ). ONCE TPZ IS IN PLACE, IT MAY NOT BE MOVED, RESIZED, REMOVED, OR ALTERED IN ANY MANNER WITHOUT PRIOR WRITTEN APPROVAL FROM OFFICE OF THE CITY FORESTER.
4. OFFICE OF THE CITY FORESTER STAFF SHALL INSPECT AND APPROVE BOUNDARIES OF TREE PROTECTION ZONE(S) PRIOR TO COMMENCEMENT OF CONSTRUCTION ACTIVITIES, INCLUDING WHEN PLASTIC FENCING IS TO BE REPLACED WITH CHAIN LINK FENCING (IF PLASTIC FENCING IS INITIALLY INSTALLED). ONCE APPROVED BY THE OFFICE OF THE CITY FORESTER, THE TREE PROTECTION ZONE SHALL NOT BE RESIZED, MODIFIED, REMOVED, OR ALTERED IN ANY MANNER WITHOUT PRIOR APPROVAL.
5. "TREE PROTECTION ZONE" SIGNS SHALL REMAIN IN PLACE AS POSTED BY OFFICE OF THE CITY FORESTER AND SHALL BE MAINTAINED IN THE CONDITION IN WHICH THEY WERE INSTALLED.
6. NO ENTRANCE AND/OR ACCESS TO THE TREE PROTECTION ZONE, INCLUDING CONSTRUCTION ACTIVITIES, IS PERMITTED WITHOUT PRIOR APPROVAL FROM THE OFFICE OF THE CITY FORESTER.
7. EXISTING ROW TREES APPROVED FOR REMOVAL BY THE OFFICE OF THE CITY FORESTER MUST BE PROTECTED IN PLACE PER FORESTRY STANDARDS & SPECIFICATIONS UNTIL REMOVED BY AN OFFICE OF THE CITY FORESTER-LICENSED TREE CONTRACTOR. A TREE REMOVAL PERMIT IS REQUIRED FROM THE OFFICE OF THE CITY FORESTER PRIOR TO REMOVAL. FAILURE TO PROTECT SUCH TREES UNTIL REMOVAL, OR REMOVING ROW TREES WITHOUT A FORESTRY-ISSUED PERMIT WILL RESULT IN NOTICE OF VIOLATION AND MAY INCLUDE CITATIONS/FINES. TREE REMOVAL PERMITS ARE NOT INCLUDED WITH BUILDING PERMITS AND MUST BE OBTAINED SEPARATELY FROM THE OFFICE OF THE CITY FORESTER.

8. NO CONSTRUCTION ACCESS, ACTIVITY, OR STORAGE OF MATERIALS/DEBRIS/EQUIPMENT IS PERMITTED WITHIN TREE PROTECTION ZONES, INCLUDING GRADING, INSTALLATION OF UNDERGROUND UTILITIES, INSTALLATION OF SITE IMPROVEMENTS, AND/OR GRUBBING/LANDSCAPING. ALL CONSTRUCTION ACTIVITY MUST OCCUR OUTSIDE TREE PROTECTION ZONES (I.E. DRIPLINES OF TREES).
9. OFFICE OF THE CITY FORESTER CONTACT: NICK EVERS, 720-675-9194 (SAK 7/19/22)

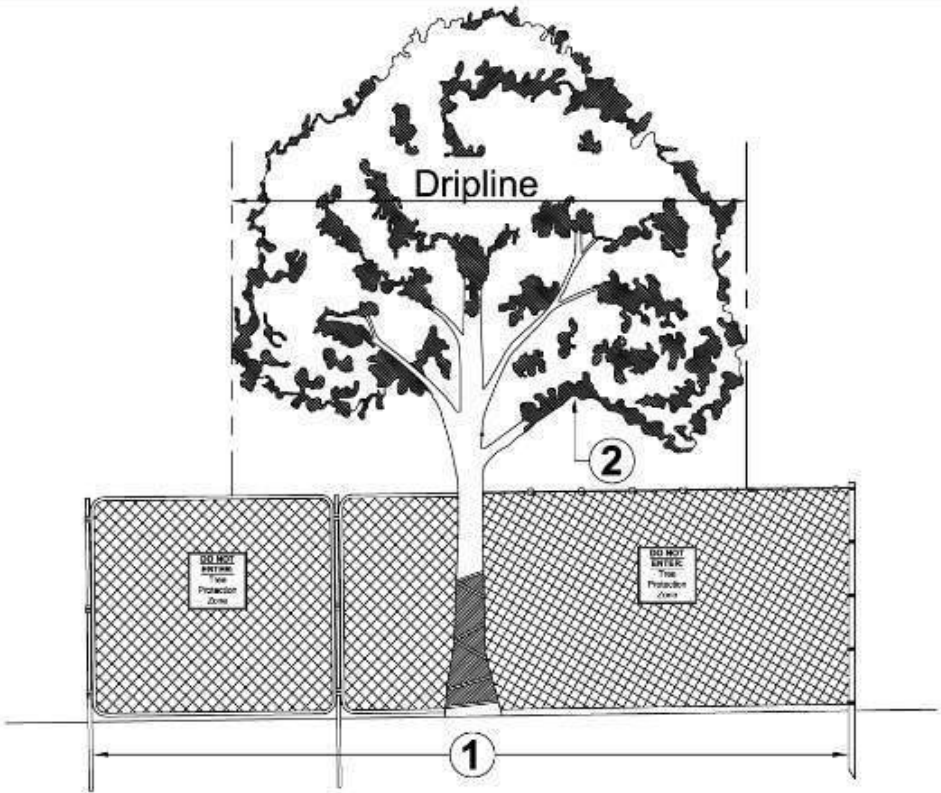

Any work in these areas must have written approval of OCF prior to commencement of activity. Contact OCF for instruction.

Area 1: Tree Protection Zone and Critical Root Zone Protection
The Tree Protection Zone (TPZ) shall be equal to dripline or 1.5 feet radially from the tree for every one inch of trunk diameter at breast height (DBH = 4.5' above soil line), whichever is greater.
A. Min 6" in height steel chain link fence is required unless otherwise approved by the Office of the City Forester (OCF). Steel chain link fence panels or rolls are acceptable.
1. When chain link rolls are installed, it shall be fastened to heavy duty steel posts with safety caps at minimum five (5) attachment points with 12-gauge wire, including points at top and bottom. Weave wire through top of roll to eliminate sag.
2. Posts shall be driven 2' to 3' below grade and spaced at max. five to ten foot (5' - 10') o.c. intervals. Fencing must be kept taut at all times.
3. "Tree Protection Zone" signs shall be placed one (1) per each tree protection zone minimum or more per direction of City Forester; maintain in the location and condition in which approved.
4. TPZ, including signage, shall be maintained in the location and condition in which approved.

The Critical Root Zone (CRZ) shall be equal to one foot radially from the tree for every one inch of trunk diameter at breast height.

Area 2: Canopy Protection
Contact OCF if potential for damage exists and/or if pruning is needed for any clearance issues prior to performing work.

Notes
1. OCF Tree Retention and Protection Specifications shall be followed throughout duration of work.
2. After TPZ is approved;
A. TPZ shall not be resized, modified, removed, or altered in any manner without prior written approval. TPZ shall be maintained in place as approved until removal is authorized by OCF.
B. Entrance/access to the TPZ is not permitted without prior written approval from the OCF.
C. No materials, debris, equipment, or site amenities shall be stored within the TPZ without prior written approval from the OCF.
3. While TPZ fencing is in place, trees shall be deep-root watered at an interval of once every two weeks when temperatures are at or above 40 degrees F. Trees shall be watered at the rate of twenty-five (25) gallons per inch DBH. OCF may ask for proof of watering.
4. Violation of TPZ or damage to protected trees is subject to penalty per City Ordinance.



City and County of Denver
Office of the City Forester
101 W. Colfax Ave, Denver, CO 80202

Tree Protection Zone Fencing Detail

Detail: OCF-TPZ 1
Effective: 2-14-2020



As Constructed	GENERAL NOTES				
No Revisions:					
Revised:	Designer:	AJL	Structure Numbers	Sheet Number	
	Detailer:	MAB			
Void:	Sheet Subset:	GN	Subset Sheets:	2 of 3	3



Print Date: 6/13/2022	Sheet Revisions		
Drawing File Name: 20005_SS4TRAF_General Notes.dgn	Date:	Comments	Init.
Horiz. Scale: 1:1			
Vert. Scale: As Noted			
	☐		
	☐		
	☐		
	☐		

alison.11:18:41 AM P:\2020 Projects\2005.01 Ped Intersection Program Development\2005\Traffic_ITS\Drawings\Alameda-Mississippi-Osage-Wolff Plan Package\2005_SS4TRAF_General Notes.dgn
6/6/2022 CDOT-DefaultPrinter_V8.plt MEC-Standard.tbl

ENVIRONMENTAL NOTES

1. ASBESTOS DEBRIS FOUND DURNING EXCAVATION

DURING EXCAVATION OR ANY SOIL DISTURBING ACTIVITY, COLORADO REGULATIONS REQUIRE ALL EXPOSED CONSTRUCTION AND DEMOLITION DEBRIS (INCLUDING ASH) BE ASSESSED FOR ASBESTOS CONTAMINATION. IT IS THE CONTRACTOR'S/SUB-CONTRACTOR'S RESPONSIBILITY FOR PROVIDING THE ONSITE PERSONNEL (CERTIFIED ASBESTOS BUILDING INSPECTOR) CAPABLE OF THIS REQUIREMENT. ANY AMOUNT OF DEBRIS FOUND TO BE CONTAMINATED WITH ASBESTOS MAY BE CLASSIFIED AS REGULATED ASBESTOS CONTAMINATED SOIL (RACS) AND MUST BE MANAGED, DOCUMENTED, AND DISPOSED OF IN ACCORDANCE WITH THE CITY AND COUNTY OF DENVER'S RACS STANDARD OPERATING PROCEDURE (SEE LINK BELOW) AND THE COLORADO SOLID WASTE REGULATIONS (6 CCR 1007- 2, PART 1). ONSITE MANAGEMENT OF RACS REQUIRES IMMEDIATE NOTIFICATION OF TRAINED FIELD PERSONNEL AT THE STATE HEALTH DEPARTMENT, AND IMPLEMENTATION OF MEASURES TO PREVENT CROSS CONTAMINATION TO THE PUBLIC. FOR ADDITIONAL INFORMATION, PLEASE CALL THE DENVER DEPARTMENT OF PUBLIC HEALTH & THE ENVIRONMENT (DDPHE) AT 720-865-5452.
https://www.denvergov.org/content/dam/denvergov/Portals/771/documents/EQ/Land%20Use%20and%20Planning/2019/CCOD_RACS_SOP_20190502_Final.pdf

2. DUST CONTROL

CONTRACTOR SHALL TAKE REASONABLE MEASURES TO PREVENT PARTICULATE MATTER FROM BECOMING AIRBORNE AND TO PREVENT THE VISIBLE DISCHARGE OF FUGITIVE PARTICULATE EMISSIONS BEYOND THE PROPERTY LINE FROM WHICH THE EMISSIONS ORIGINATE. THE MEASURES TAKEN MUST BE EFFECTIVE AT ALL TIMES ON THE SITE, INCLUDING PERIODS OF INACTIVITY SUCH AS EVENINGS, WEEKENDS, AND HOLIDAYS AS WELL AS ANY OTHER PERIOD OF INACTIVITY.

3. UNEXPECTED DISCOVERY

DURING ANY SOIL DISTURBING ACTIVITIES, IF UNKNOWN/UNIDENTIFIED UNDERGROUND STORAGE TANKS, DRUMS, ODOROUS SOIL, STAINED SOIL, ASBESTOS-CEMENT PIPE (TRANSITE), BUILDING DEBRIS, OR WASTE MATERIALS ARE ENCOUNTERED, CONTRACTOR SHALL IMMEDIATELY STOP WORK IN THE AREA OF THE DISCOVERY UNTIL DDPHE MAKES A DETERMINATION OF HOW TO PROCEED. CONTRACTOR SHALL IMMEDIATELY NOTIFY DDPHE OF THE DISCOVERY AT (303) 495-8376.

4. SOIL REUSE

EXCESS SOIL FROM A CCD PROJECT MAY BE REUSED AT ANOTHER CCD PROPERTY OR A THIRDPARTY SITE ONLY IF THE CRITERIA ESTABLISHED IN THE DDPHE OCTOBER 5, 2017, MEMORANDUM TITLED "GUIDANCE FOR REUSE OF SOIL ON CITY PROJECTS" ARE MET AND THE SOIL IS FREE OF ODORS, STAINING, AND DEBRIS. THE GUIDANCE IS LOCATED ON OUR WEBSITE UNDER THE "ABOUT" TAB FOR ENVIRONMENTAL REVIEW AND ASSESSMENT: https://www.denvergov.org/content/dam/denvergov/Portals/771/documents/EQ/Land%20Use%20and%20Planning/2019/Soil_Reuse_Guidance.pdf

5. IMPORTED SOIL

FILL MATERIAL OR SOIL TO BE IMPORTED AND PLACED ON CCD-OWNED PROPERTY OR PLACED ON REAL PROPERTY TO BE TRANSFERRED TO THE CCD MUST BE FREE OF KNOWN CONTAMINATION (OBSERVED AND DOCUMENTED, OR PREVIOUSLY DOCUMENTED) AND BE ACCEPTABLE FOR UNRESTRICTED RESIDENTIAL USE. CONTACT DAVE ERICKSON (720 865 5433) FOR CLARIFICATION IF NEEDED.

6. DISPOSAL

THE CONTRACTOR SHALL DIRECT NON-RECYCLABLE, NON-HAZARDOUS WASTES FROM CCDOWNED OR CONTROLLED PROPERTY OR FACILITIES TO THE DENVER ARAPAHOE DISPOSAL SITE (DADS) LANDFILL FOR DISPOSAL, FOLLOWING THE REQUIREMENTS AND PROCEDURAL GUIDANCE PER CCD EXECUTIVE ORDER 115. LABORATORY ANALYTICAL RESULTS WILL BE REQUIRED PRIOR TO DADS ACCEPTANCE FOR SOIL AND POSSIBLY OTHER MATERIALS. EARLY TESTING IS RECOMMENDED; DDPHE CAN ASSIST. CONTACT DDPHE AT 720 865 5448 WITH QUESTIONS.

7. NOISE CONTROL.

ALL NOISE CAUSED BY CONSTRUCTION OF, OR RESULTING FROM, COMPLETED PROJECTS, MUST COMPLY WITH DENVER'S NOISE ORDINANCE, D.R.M.C. CHAPTER 36 "NOISE CONTROL, ". EXEMPTED HOURS FOR CONSTRUCTION IN THE CITY AND COUNTY OF DENVER ARE FROM 7 A.M. TO 9 P.M. MONDAY THROUGH FRIDAY AND 8 A.M. TO 5 P.M. ON SATURDAYS AND SUNDAYS. IF

THERE IS A NEED TO WORK OUTSIDE OF THE EXEMPTED HOURS: 1) THE CONTRACTOR MUST REQUEST A VARIANCE, AND 2) THE VARIANCE PROCESS NEEDS TO BE STARTED A MINIMUM OF THREE MONTHS PRIOR TO THE DESIRED START DATE. ANY QUESTIONS SHOULD BE DIRECTED TO PAUL RIEDESEL, DDPHE COMMUNITY NOISE PROGRAM, 720-865-5410.




Print Date: 6/6/2022			Sheet Revisions			DENVER TRANSPORTATION & INFRASTRUCTURE	As Constructed		GENERAL NOTES			
Drawing File Name: 20005_SS4TRAF_General Notes.dgn			Date:	Comments	Init.		No Revisions:					
Horiz. Scale: 1:1 Vert. Scale: As Noted							Revised:		Designer: AJL	Structure Numbers	Sheet Number	
MULLER ENGINEERING COMPANY								Detailer: MAB				
								Void:	Sheet Subset: GN	Subset Sheets: 3 of 3	4	

alison 9/26/2020 AM 10:00:05.01 Pac Intersection Program Development\20005\Traffic_ITSDrawings\Alameda-Mississippi-Osage-Wolff Plan Package\20005_SS4TRAF_SAQ_July 2021.dgn
CDOT-DefaultPrinter_V8.pltlog MEC-Standard.ctb

SUMMARY OF APPROXIMATE QUANTITIES																		
INDEX			CONTRACT ITEM NO.	CONTRACT ITEM	UNIT	Alameda Ave & Franklin St		Mississippi Ave & Downing St		Osage Street School Crossing		Wolff St & 17th Ave (By Others)						PROJECT TOTALS
BOOK	PAGE	SHEET				PLAN	AS CONST.	PLAN	AS CONST.	PLAN	AS CONST.	PLAN	AS CONST.	PLAN	AS CONST.	PLAN	AS CONST.	
			202-00200	REMOVAL OF SIDEWALK	SY			4.25		9								13
			202-00203	REMOVAL OF CURB AND GUTTER	LF			65		21								86
			202-00220	REMOVAL OF ASPHALT MAT	SY			40				40						40
			202-00250	REMOVAL OF PAVEMENT MARKING	SF	480		210				470						690
			202-00810	REMOVAL OF GROUND SIGN	EA	2		2		1								5
			202-00821	REMOVAL OF SIGN PANEL	EA	2				1								3
			210-00810	RESET GROUND SIGN	EA			1										1
			212-00050	SOD	SF			180		36								216
			403-00721	HOT MIX ASPHALT (PATCHING) (ASPHALT)	SY	12.25		23				23						35
			304	CRUSHER FINES														15
			604	4" PVC SLEEVE														67
			608-00006	CONCRETE SIDEWALK (6														71
			608-00010	CONCRETE CURB RAMP														20
			608-00015	CCD TRUNCATED DOME														47
			609-20010	CURB TYPE 2 (SECTION E														104
			610-00024	MEDIAN COVER MATERIA														75
			612-00013	DELINEATOR (SPECIAL) (HARDENED CENTERLINE)	EA	1												1
			612-00044	DELINEATOR (FLEXIBLE) (POST A)		2												2
			612-00045	DELINEATOR (FLEXIBLE) (POST B)	EA	2												2
			614-00011	SIGN PANEL (CLASS I)	SF	52.25		36		92								180
			614-00216	STEEL SIGN POST (2X2 INCH TUBING)	LF	10		50		120		20						180
			614-80003	RAPID RECTANGULAR FLASHING BEACON	EA	2												2
			622-00250	BENCH	EA			1										1
			624-70043	3' LONG RUBBERIZED PARKING BLOCKS	EA	26												26
			627-00005	MODIFIED EPOXY PAVEMENT MARKING	GAL	5		6		2		6						13
			627-30405	PREFORMED THERMOPLASTIC PAVEMENT MARKING (WORD-SYMBOL)	SF	149						24						149
			627-30410	PREFORMED THERMOPLASTIC PAVEMENT MARKING (X-WALK/STOP LINE)	SF	413		229		75		214						717
			627-70038	RAISED PAVEMENT MARKER "CITY POSTS" (ASPHALT INSTALLATION)(WHITE)	EA	18		5		8								1
			627-70051	MODULAR RUBBER SPEED BUMP (YELLOW)	EA	1				6								1
			627-70052	MODULAR RUBBER SPEED BUMP END CAP (YELLOW)	EA	2												2

 See updated bid tab for
combined projects



Print Date: 7/18/2022		0000	Sheet Revisions				As Constructed		SUMMARY OF APPROXIMATE QUANTITIES					
Drawing File Name: 20005_SS4TRAF_SAQ_July 2021.dgn			Date:	Comments	Init.		No Revisions:							
Horiz. Scale: 1:1							Revised:		Designer: AJL		Structure Numbers		Sheet Number	
Vert. Scale: As Noted							Void:		Detailer: MAB					
							Sheet Subset: SAQ		Subset Sheets: 1 of 1		5			

alison 9/20/2020 AM P:\2020 Projects\20-005.01 Ped Intersection Program Development\20005\Traffic_ITS\Drawings\Alameda-Mississippi-Osage-Wolff Plan Package\20005_SS4TRAF_Sign Schedule.dgn
7/18/2022 CDOT-DefaultPrinter_V8.plt MEC-Standard.tbl

PAGE	SIGNCODE	WORK				INSTALLATION			DESCRIPTION
		RESET SIGN	RESET SIGN POST	REMOVE SIGN	REMOVE SIGN POST	NEW SIGN PANEL	NEW SIGN POST	NEW PEDESTAL POLE	
ALAMEDA 1 OF 4	R3-7R			X	X				RIGHT LANE MUST TURN RIGHT
ALAMEDA 1 OF 4	R3-5R			X	X				RIGHT TURN ONLY
ALAMEDA 2 OF 4	W9-1			X					RIGHT LANE ENDS
ALAMEDA 2 OF 4	W16-8P			X					"AT FRANKLIN ST
ALAMEDA 2 OF 4	30W4-2R					X			LANE ENDS
ALAMEDA 2 OF 4	30W9-2L					X			LANE ENDS MERGE LEFT
ALAMEDA 3 OF 4	18R4-7C					X	X		NARROW KEEP RIGHT
ALAMEDA 3 OF 4	12OM-3L					X			OBJECT MARKER
ALAMEDA 3 OF 4	30W11-2					X		X	PEDESTRIAN CROSSING
ALAMEDA 3 OF 4	30W11-2					X			PEDESTRIAN CROSSING
ALAMEDA 3 OF 4	24W16-7PL					X			SUPPLEMENTAL ARROW (PLAQUE)
ALAMEDA 3 OF 4	24W16-7PL					X			SUPPLEMENTAL ARROW (PLAQUE)
ALAMEDA 3 OF 4	30W11-2					X		X	PEDESTRIAN CROSSING
ALAMEDA 3 OF 4	30W11-2					X			PEDESTRIAN CROSSING
ALAMEDA 3 OF 4	24W16-7PL					X			SUPPLEMENTAL ARROW (PLAQUE)
ALAMEDA 3 OF 4	24W16-7PL					X			SUPPLEMENTAL ARROW (PLAQUE)
MISSISSIPPI 1 OF 4	24R7-10AR/35(A)	X	X						NO PARKING (LEFT)/STREET SWEEPING
MISSISSIPPI 1 OF 4	12R7-35D			X	X				STREET SWEEPING
MISSISSIPPI 1 OF 4	12R7-35C			X	X				STREET SWEEPING
MISSISSIPPI 1 OF 4	BUS STOP SIGN (SPECIAL)	X	X						BUS STOP
MISSISSIPPI 2 OF 4	24R7-35D/10AR					X	X		STREET SWEEPING/NO PARKING (RIGHT)
MISSISSIPPI 2 OF 4	24R7-10AL/35C					X	X		NO PARKING (LEFT)/STREET SWEEPING
MISSISSIPPI 2 OF 4	30W11-2					X	X		PEDESTRIAN CROSSING
MISSISSIPPI 2 OF 4	24W16-7PL					X			SUPPLEMENTAL ARROW (PLAQUE)
MISSISSIPPI 2 OF 4	18R4-7C					X	X		NARROW KEEP RIGHT
MISSISSIPPI 2 OF 4	12OM-3L					X			OBJECT MARKER
MISSISSIPPI 2 OF 4	18R4-7C					X			NARROW KEEP RIGHT
MISSISSIPPI 2 OF 4	12OM-3L					X			OBJECT MARKER
MISSISSIPPI 2 OF 4	30W11-2					X	X		PEDESTRIAN CROSSING
MISSISSIPPI 2 OF 4	24W16-7PL					X			SUPPLEMENTAL ARROW (PLAQUE)
OSAGE 1 OF 3	12R7-35B			X					STREET SWEEPING
OSAGE 1 OF 3	24R7-166L/35A			X	X				LOADING ONLY (LEFT)/STREET SWEEPING
OSAGE 2 OF 3	24R7-10AL/35B					X	X		NO PARKING (LEFT)/STREET SWEEPING
OSAGE 2 OF 3	30S1-1					X			SCHOOL CROSSING
OSAGE 2 OF 3	24W16-7PL					X			SUPPLEMENTAL ARROW (PLAQUE)
OSAGE 2 OF 3	24R7-35B/10AR					X	X		STREET SWEEPING/NO PARKING
OSAGE 2 OF 3	24R7-166/10AR					X	X		LOADING ONLY (LEFT)/NO PARKING (RIGHT)
OSAGE 2 OF 3	30S1-1					X	X		SCHOOL CROSSING
OSAGE 2 OF 3	24W16-7PL					X			SUPPLEMENTAL ARROW (PLAQUE)
OSAGE 2 OF 3	24R7-10AL/35A					X	X		NO PARKING (LEFT)/STREET SWEEPING
OSAGE 3 OF 3	36S1-1					X	X		SCHOOL CROSSING
OSAGE 3 OF 3	36S16-9P					X			AHEAD
OSAGE 3 OF 3	24S5-2B					X	X		END SCHOOL ZONE
OSAGE 3 OF 3	24R2-1(25)					X			SPEED LIMIT (25 MPH)
OSAGE 3 OF 3	24S2-1A					X	X		SCHOOL ZONE FINES DOUBLED
OSAGE 3 OF 3	24R2-1(25)					X			SPEED LIMIT (25 MPH)
OSAGE 3 OF 3	36S1-1					X			SCHOOL CROSSING
OSAGE 3 OF 3	36S16-9P					X			AHEAD
OSAGE 3 OF 3	24S5-2B					X	X		END SCHOOL ZONE
OSAGE 3 OF 3	24R2-1(25)					X			SPEED LIMIT (25 MPH)
OSAGE 3 OF 3	24S2-1A					X	X		SCHOOL ZONE FINES DOUBLED
OSAGE 3 OF 3	24R2-1(25)					X			SPEED LIMIT (25 MPH)
WOLFF 2 OF 4	18R4-7C					X	X		NARROW KEEP RIGHT
WOLFF 2 OF 4	12OM-3L					X			OBJECT MARKER
WOLFF 2 OF 4	18R4-7C					X			NARROW KEEP RIGHT
WOLFF 2 OF 4	12OM-3L					X			OBJECT MARKER
WOLFF 2 OF 4	30W11-2					X	X		PEDESTRIAN CROSSING
WOLFF 2 OF 4	24W16-7PL					X			SUPPLEMENTAL ARROW (PLAQUE)
WOLFF 2 OF 4	30W11-2					X			PEDESTRIAN CROSSING
WOLFF 2 OF 4	24W16-7PL					X			SUPPLEMENTAL ARROW (PLAQUE)
WOLFF 2 OF 4	30W11-2					X			PEDESTRIAN CROSSING
WOLFF 2 OF 4	24W16-7PL					X			SUPPLEMENTAL ARROW (PLAQUE)
WOLFF 2 OF 4	30W11-2					X			PEDESTRIAN CROSSING
WOLFF 2 OF 4	24W16-7PL					X			SUPPLEMENTAL ARROW (PLAQUE)
WOLFF 2 OF 4	12R7-10A					X	X		NO PARKING



Print Date: 7/18/2022
Drawing File Name: 20005_SS4TRAF_Sign Schedule.dgn
Horiz. Scale: 1:1 Vert. Scale: As Noted



0000

Sheet Revisions

Date:	Comments	Init.



As Constructed

No Revisions:
Revised:
Void:

SIGN SCHEDULE

Designer:	AJL	Structure		Sheet Number 6
Detailer:	AJL	Numbers		
Sheet Subset:	SIGNS	Subset Sheets:	1 of 1	


alison.11:39:54 AM P:\2020 Projects\20005.01 Ped Intersection Program Development\200051Traffic_ITS\Drawings\Alameda-Mississippi-Osage-Wolff Plan Package\20005_SS4TRAF_Ped-Alameda.dgn
CDOT V81 Signage.tbl



NOTES:
1. ALL PROPOSED SIGNS ARE PROVIDED ON INTERSECTION DETAIL SHEET.

LEGEND OF EXISTING SIGNING

- | | |
|--|---|
| (A) NO PARKING RIGHT ARROW (SR7-10AR) | (F) RIGHT TURN ONLY (R3-5R) |
| (B) NO PARKING LEFT ARROW (SR7-10AL) | (G) BUS STOP |
| (C) STREET NAME SIGN (D3-1) | (H) NO PARKING (LEFT)/STREET SWEEPING 1ST TUESDAY (24R7-10AL/35(A)) |
| (D) STOP SIGN (R1-1) | (I) RIGHT LANE MUST TURN RIGHT (R3-7R) |
| (E) TWO HOUR PARKING (LEFT) NO PARKING (RIGHT) (24SR7-140SP-DL/10AR) | |

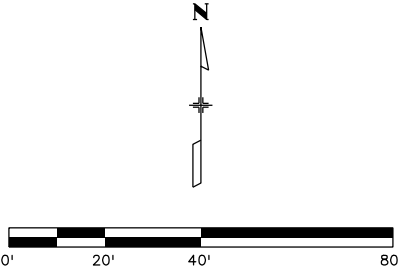

Print Date: 6/6/2022
Drawing File Name: 20005_SS4TRAF_Ped-Alameda.dgn
Horiz. Scale: 1:40 Vert. Scale: As Noted



0000

Sheet Revisions

Date:	Comments	Init.



As Constructed

No Revisions:

Revised:

Void:

ALAMEDA AVENUE & FRANKLIN STREET
REMOVAL PLAN


Designer:	AJL	Structure Numbers	
Detailer:	MAB		
Sheet Subset:	ALAMEDA	Subset Sheets:	1 of 4

Sheet Number

7

slition 11/3/2022 AM 1:30:07 PM P:\2020 Projects\2005\01 Ped Intersection Program Development\2005\Traffic\ITS\Drawings\Alameda-Mississippi-Osage-Wolff Plan Package\2005_SS4TRAF_Ped-Alameda Lafayette to Humboldt.dgn
CDOT V8I Signats.tbl

- 5 4" SKIP WHITE LANE LINE, 10' LINE, 30' GAP
- 8 8" SOLID WHITE RIGHT EDGE LINE OR TURN LANE LINE
- 19 PAVEMENT MESSAGES ONLY WHEN SHOWN ON PLANS

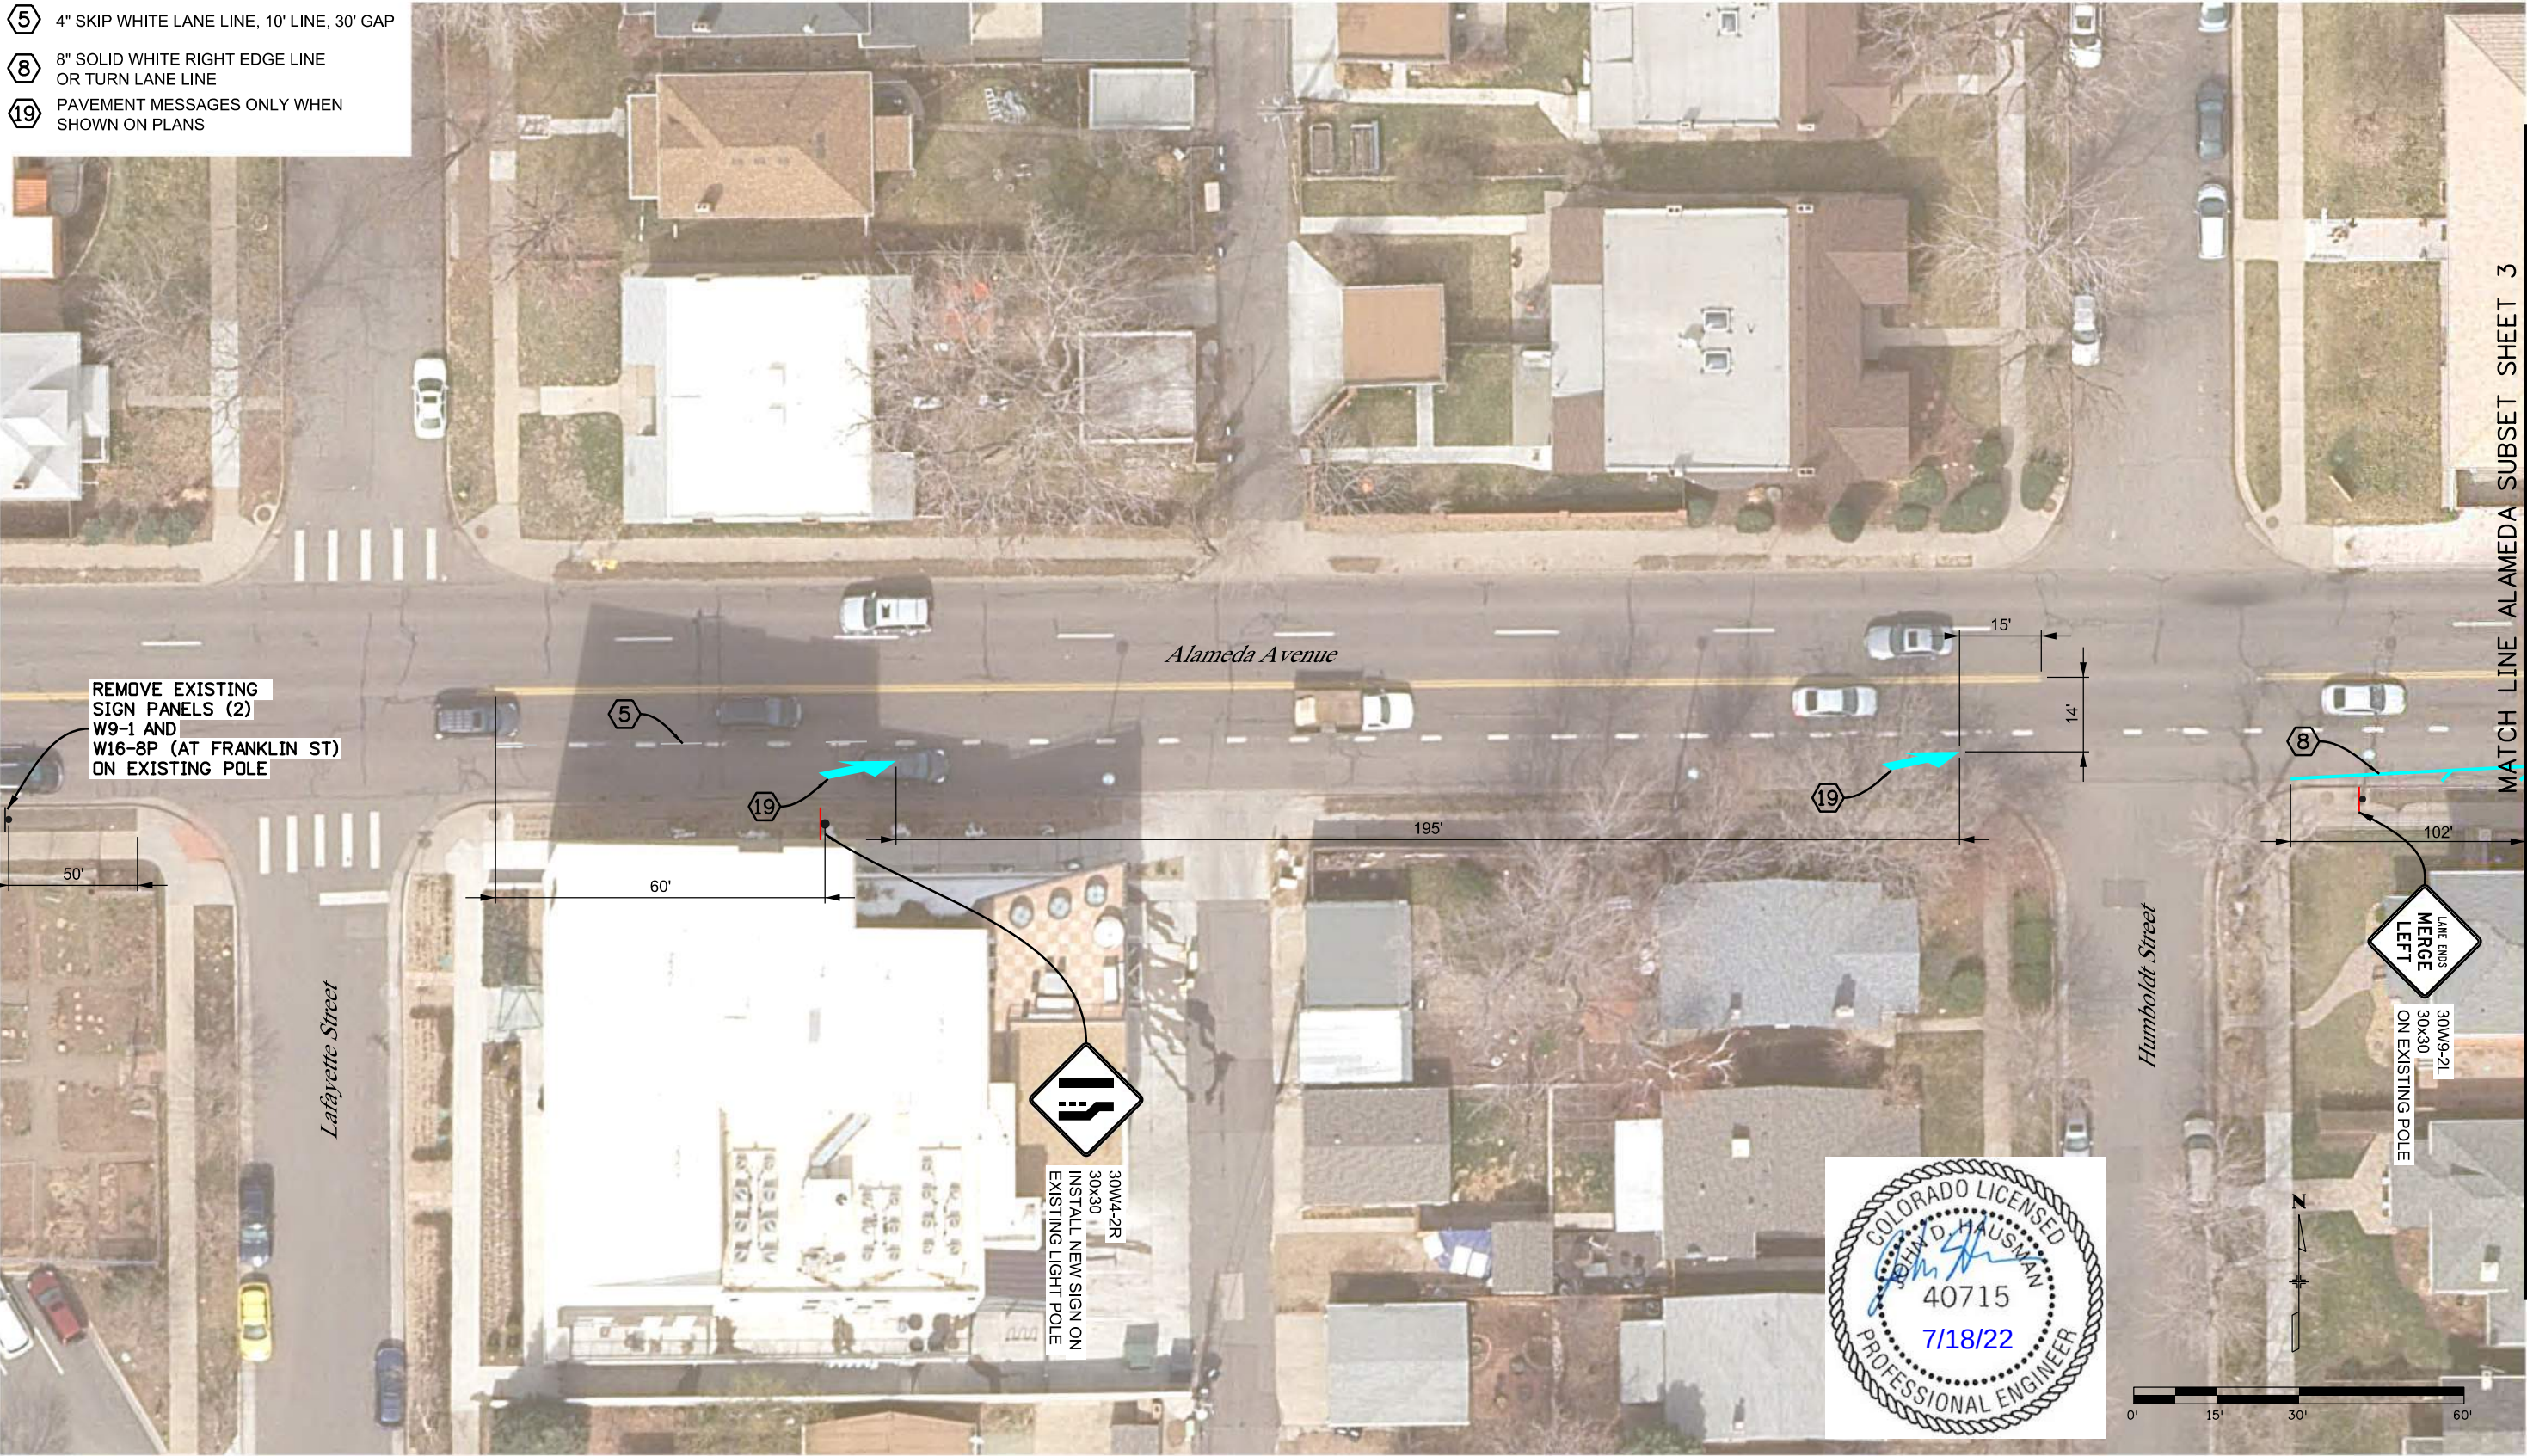

Print Date: 6/13/2022
Drawing File Name: 20005_SS4TRAF_Ped-Alameda Lafayette to Humboldt.dgn
Horiz. Scale: 1:30 Vert. Scale: As Noted



0000

Sheet Revisions

Date:	Comments	Init.



As Constructed

No Revisions:

Revised:

Void:

LAFAYETTE ST TO HUMBOLDT ST
SIGNING AND STRIPING DETAIL


Designer:	AJL	Structure Numbers	
Detailer:	REW		
Sheet Subset:	ALAMEDA	Subset Sheets:	2 of 4

Sheet Number

8

Revision: 9:28:20 AM P:\200405-01 Ped Intersection Program Development\200505\Traffic_TSD\Drawings\Mameda-Mississippi-Osage-Wolf Plan Package\2005_SS4TRAF_Ped-Alameda Detail.dgn 1/8/2022 C:\001-V8I Signals.tbl C:\001-Default\Printer V8I.pltfig

alison.12/26/2020 PM 1:20:20 Projects\2005\01 Ped Intersection Program Development\2005\Traffic_ITS\Drawings\Alameda-Mississippi-Osage-Wolff Plan Package\2005_SS4TRAF_Ped-Alameda Truck Turning Template.dgn
7/12/2022 CDOT-Default\Inter_V8.plt

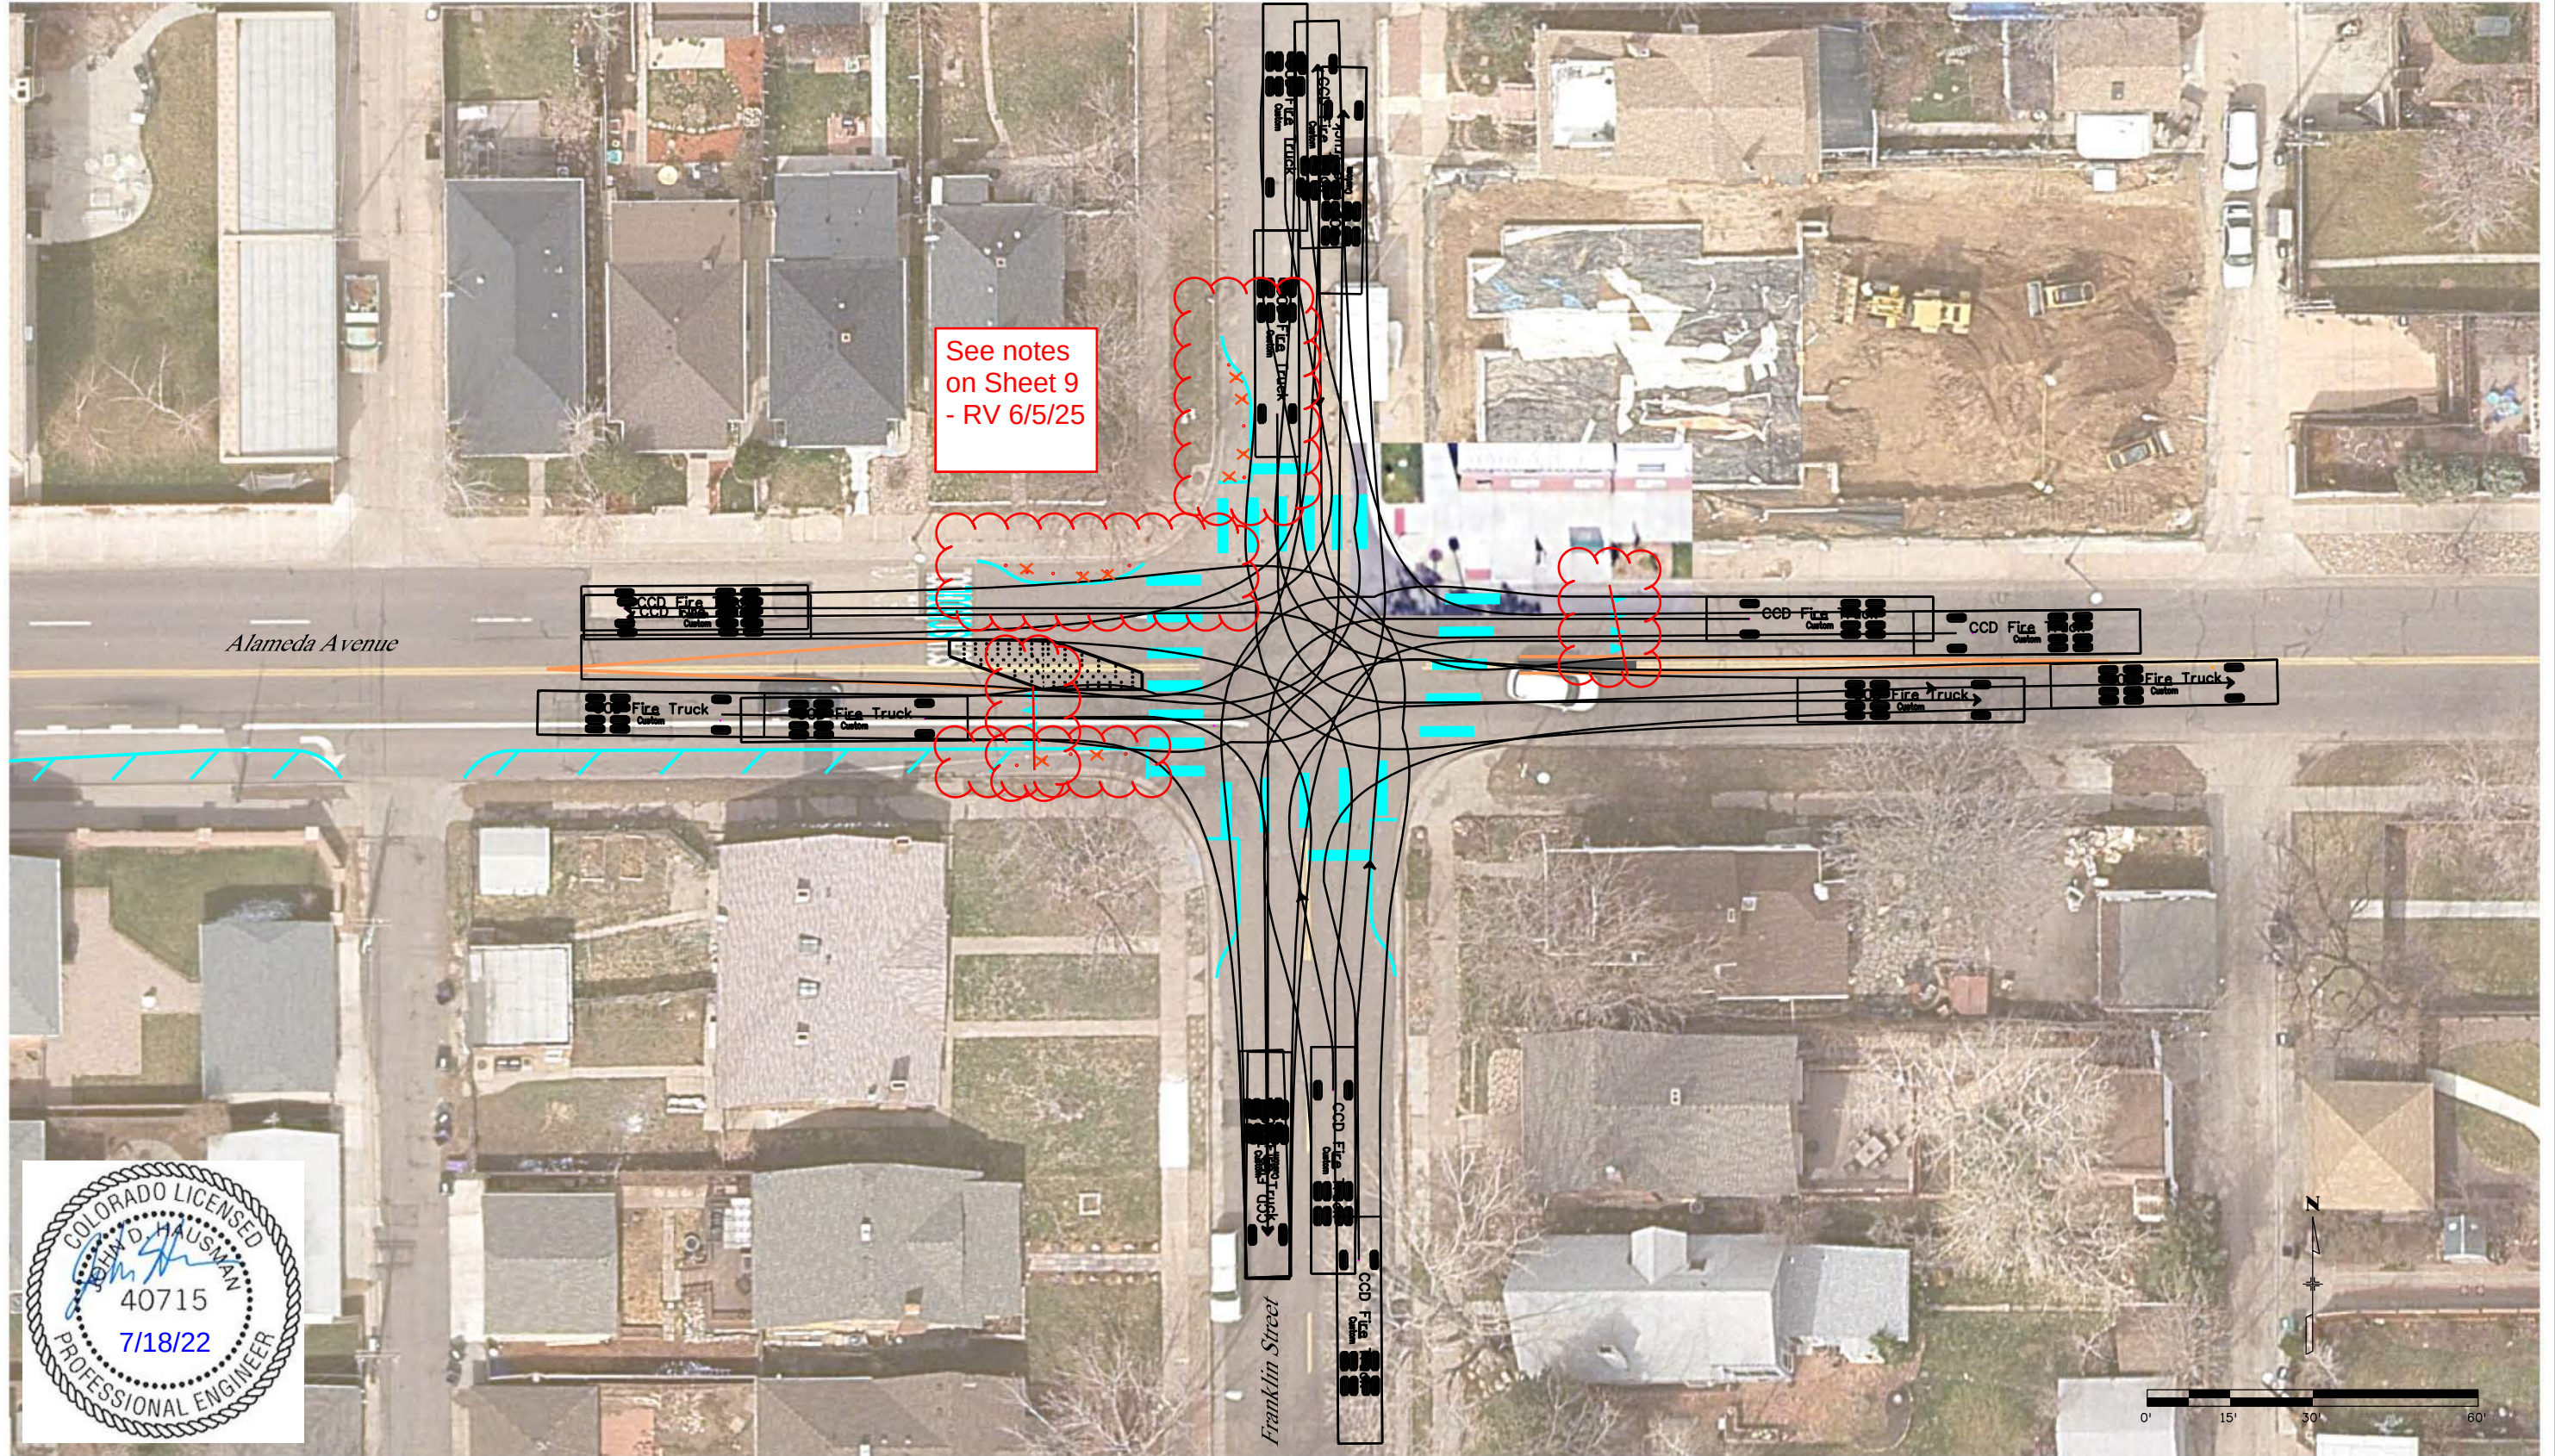

Print Date: 7/12/2022
Drawing File Name: 20005_SS4TRAF_Ped-Alameda Truck Turning Template.dgn
Horiz. Scale: 1:30 Vert. Scale: As Noted




0000

Sheet Revisions		
Date:	Comments	Init.



As Constructed		ALAMEDA AVENUE & FRANKLIN STREET CCD FIRE TRUCK TURNING TEMPLATE			
No Revisions:					
Revised:		Designer: AJL	Structure Numbers	Sheet Number 10	
Void:		Detailer: MAB			
		Sheet Subset: ALAMEDA	Subset Sheets: 4 of 4		

Top: 4:25:13 PM User: hprojects\2020 Projects\20005\Traffic ITS Drawings\Alameda-Mississippi-Osage-Wolff Plan Package\20005_SS4TRAF_Ped-Mississippi.dgn
CDOT-V8I Signals.tbl
7/5/2022

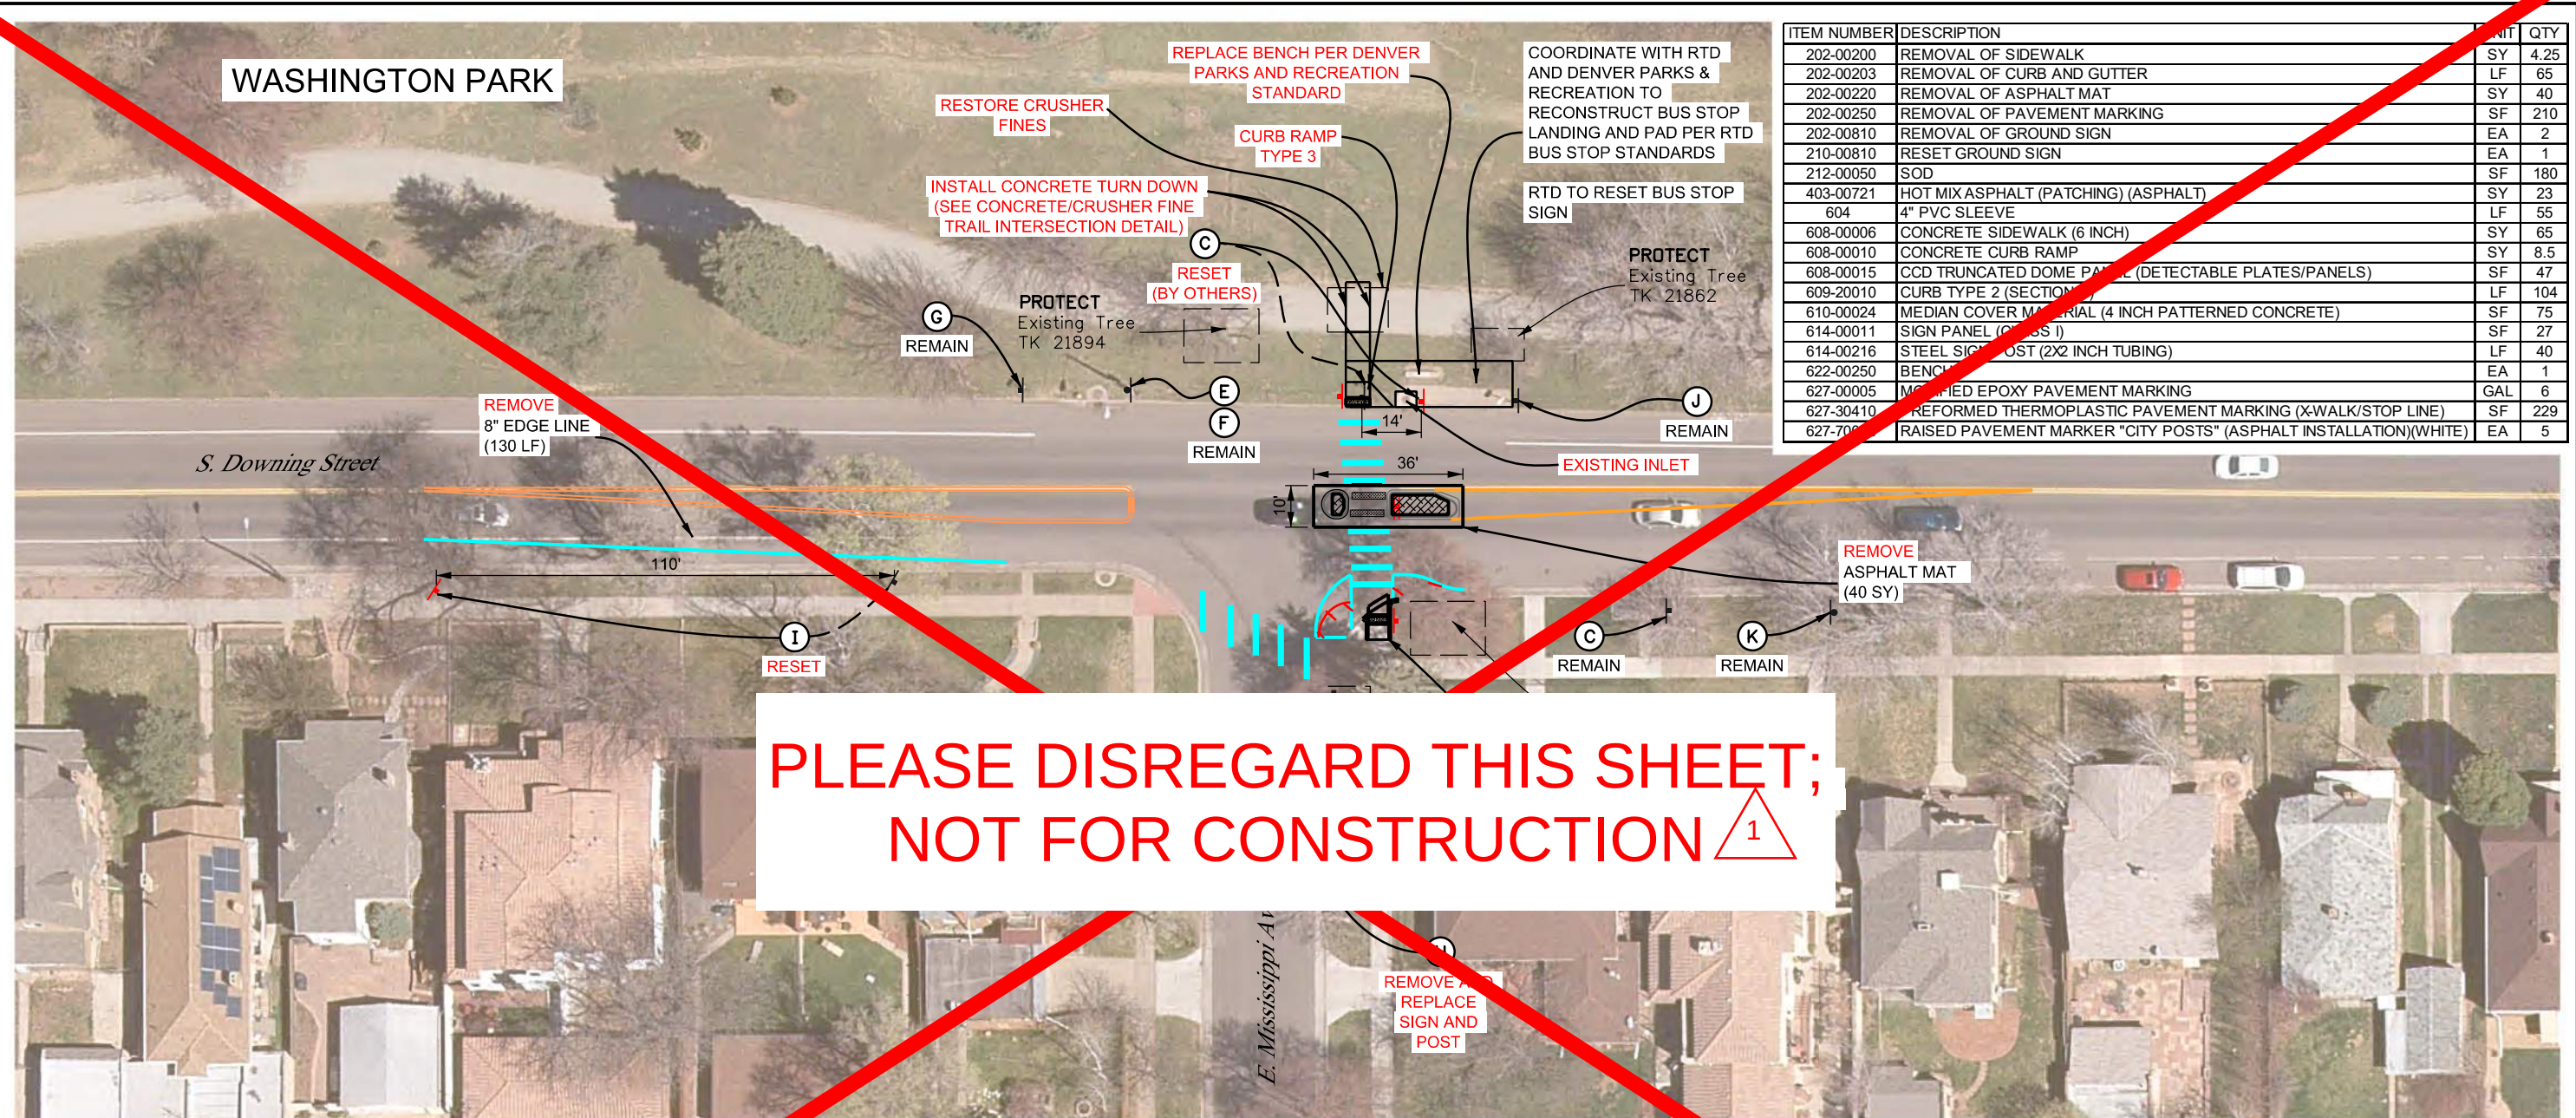

ITEM NUMBER	DESCRIPTION	UNIT	QTY
202-00200	REMOVAL OF SIDEWALK	SY	4.25
202-00203	REMOVAL OF CURB AND GUTTER	LF	65
202-00220	REMOVAL OF ASPHALT MAT	SY	40
202-00250	REMOVAL OF PAVEMENT MARKING	SF	210
202-00810	REMOVAL OF GROUND SIGN	EA	2
210-00810	RESET GROUND SIGN	EA	1
212-00050	SOD	SF	180
403-00721	HOT MIX ASPHALT (PATCHING) (ASPHALT)	SY	23
604	4" PVC SLEEVE	LF	55
608-00006	CONCRETE SIDEWALK (6 INCH)	SY	65
608-00010	CONCRETE CURB RAMP	SY	8.5
608-00015	CCD TRUNCATED DOME PANEL (DETECTABLE PLATES/PANELS)	SF	47
609-20010	CURB TYPE 2 (SECTION 7)	LF	104
610-00024	MEDIAN COVER MATERIAL (4 INCH PATTERNED CONCRETE)	SF	75
614-00011	SIGN PANEL (CLASS I)	SF	27
614-00216	STEEL SIGN POST (2X2 INCH TUBING)	LF	40
622-00250	BENCH	EA	1
627-00005	MODIFIED EPOXY PAVEMENT MARKING	GAL	6
627-30410	REFORMED THERMOPLASTIC PAVEMENT MARKING (X-WALK/STOP LINE)	SF	229
627-70002	RAISED PAVEMENT MARKER "CITY POSTS" (ASPHALT INSTALLATION)(WHITE)	EA	5

PLEASE DISREGARD THIS SHEET;
NOT FOR CONSTRUCTION

LEGEND OF EXISTING SIGNING

- (A)

STREET NAME SIGN (D3-1)
- (B)

STOP SIGN (R1-1)
- (C)

BUS STOP
- (D)

STREET SWEEPING 1ST FRIDAY (12R7-35D)
- (E)

SAFETY ZONE SIGN (SPECIAL)
- (F)

30 MPH SPEED LIMIT SIGN (R2-1(30))

(G)

STREET SWEEPING 1ST WEDNESDAY/NO PARKING (RIGHT) (24R735(B)/10AR)

(H)

STREET SWEEPING 1ST THURSDAY (12R7-35C)

(I)

NO PARKING (LEFT)/STREET SWEEPING 1ST TUESDAY (24R7-10AR/35(A))

(J)

NO PARKING (LEFT)/STREET SWEEPING 1ST WEDNESDAY (24R7-10AR/35(B))

(K)


STREET SWEEPING 1ST TUESDAY/NO PARKING (RIGHT) (24R7-35(A)/10AR)

CONSTRUCTION NOTES:

1. INSTALL CITY POSTS 2\"/>

LEGEND

- CITY POST (TYPE C)
- SIGN PROPOSED
- SIGN EXISTING

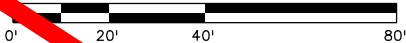

Print Date: 7/5/2022

Drawing File Name: 20005_SS4TRAF_Ped-Mississippi.dgn

Horiz. Scale: 1\"/>

Sheet Revisions			
Date:	Comments	Init.	

As Constructed

No Revisions:

Revised:

Void:

E. MISSISSIPPI AVENUE & S. DOWNING STREET
SIGNING AND STRIPING REMOVALS

Designer: AJL

Detailer: MAB

Sheet Subset: MISSISSIPPI

Structure Numbers

Subset Sheets: 1 of 4

Sheet Number: 11

LEGEND:



- CITY POST (TYPE C)
- SIGN PROPOSED — SIGN EXISTING
- ① 4" DOUBLE YELLOW CENTERLINE WITH 4" SEPERATION
- ⑧ 8" SOLID WHITE RIGHT EDGE LINE OR TURN LANE LINE
- ①⑥ 18"x10' WHITE CROSSWALK BARS
- ①⑧ 24" WHITE STOP LINE, ONLY WHEN SHOWN ON PLANS
- ②⑥ 4" SOLID YELLOW EDGE LINE

NOTE:
COORDINATE WITH DENVER PARKS AND RECREATION
FOR PLACEMENT OF ALL GROUND SIGNS WITHIN
WASHINGTON PARK

WASHINGTON PARK

RESET BUS STOP
SIGN (SEE PREVIOUS
SHEET)

PLEASE DISREGARD THIS SHEET;
NOT FOR CONSTRUCTION

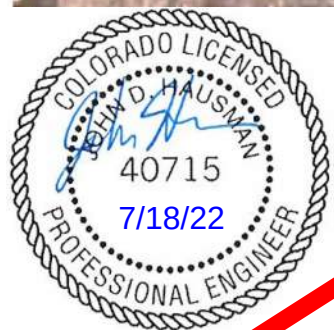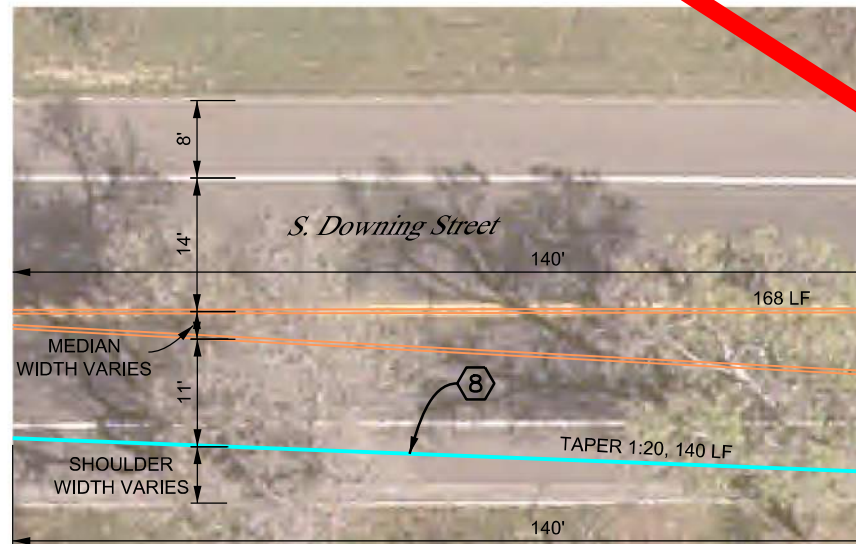


24R7-35D/10AR
24x18

E. Mississippi Avenue

24R7-10AL/35C
24x18

MOUNTED
BACK TO BACK

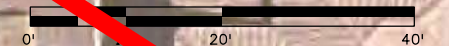

Print Date: 7/12/2022
Drawing File Name: 20005_SS4TRAF_Ped-Mississippi Detail.dgn
Horiz. Scale: 1"=20' Vert. Scale: As Noted



Sheet Revisions

Date:	Comments	Init.



As Constructed

No Revisions:

Revised:


Void:

E. MISSISSIPPI AVENUE & S. DOWNING STREET
SIGNING AND STRIPING DETAIL

Designer:	AJL	Structure	
Detailer:	MAB	Numbers	
Sheet Subset:	MISSISSIPPI	Subset Sheets:	2 of 4

Sheet Number

12

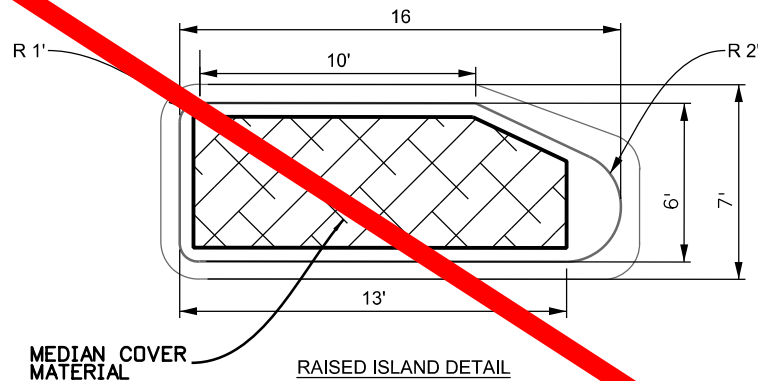

CONCRETE LANDING PAD TO BE INSTALLED WITHIN EXISTING PARK TRAIL PER STANDARD (SEE DETAIL SHEET). CONTRACTOR TO COORDINATE WORK WITH DENVER PARKS AND RECREATION.

INSTALL A 4" PVC SLEEVE UNDER NEW SIDEWALK, 12" FROM THE BIKE PATH EDGE

CONSTRUCT SIDEWALK SEGMENT CONNECTIONG EXISTING SIDEWALK 6' WIDE PER DENVER PARKS & REC STANDARDS AND INCLUDE FIBER MESH (SEE CONCRETE PAVEMENT DETAIL)

TURFGRASS RESTORATION SHALL BE TURFGRASS SOD (180 SF)

ADA LANDING AREA

CONSTRUCT TYPE 3 (STD DWG 7.1) CURB RAMP. 6' WIDE PER DENVER PARKS & REC STANDARDS.

UNPAINTED CAST IRON TRUNCATED DOMES PER DENVER PARKS AND REC STANDARDS

INSTALL CONTINUOUS 4" PVC SLEEVE UNDER RTD PAD AND NEW RAMP AND SIDEWALK (12" AWAY FROM EDGE).

IF AN IRRIGATION HEAD IS PRESENT WITHIN THE PROPOSED IMPROVEMENT AREA, THE LATERAL LINE SHALL BE REPLACED WITH A FULL, UN-SPLICED SECTION OF POLY PIPE, INSTALLED IN PVC SLEEVE.

COORDINATE WITH RTD FOR BUS STOP CONSTRUCTION - PER RTD STANDARD SD-C101

REFERENCE POINT: BEGINNING OF LANDSCAPING

REMOVE APPROX. 60 LF OF CURB AND GUTTER. CONFIRM EXTENTS WITH PROJECT ENGINEER BASED ON CONDITION IN FIELD.

EXISTING INLET TO BE REMOVED AND REPLACED BY OTHERS. COORDINATE WITH DENVER WASTEWATER AND PROJECT ENGINEER.

CONCRETE POURED MONOLITHICALLY

PLEASE DISREGARD THIS SHEET;
NOT FOR CONSTRUCTION



CURB AND GUTTER (SECTION 1)

MONOLITHIC MEDIAN NOSE (CCD STD DWG 5.6)

TRUNCATED DOME PANEL (CCD STD DWG 7.0)


REMOVE ASPHALT PAVEMENT (40 SY)

REMOVE EXISTING SIDEWALK (4.25 SY), CURB AND GUTTER (5.5 LF) REMOVAL OF EXISTING CONCRETE CURB GUTTER AND SIDEWALK SHALL OCCUR AT EXISTING JOINT LINES


TRUNCATED DOME PANEL

PROPOSED TYPE 3 CURB RAMP (STD DWG 7.1)

EXISTING INLET (PROTECT IN PLACE)

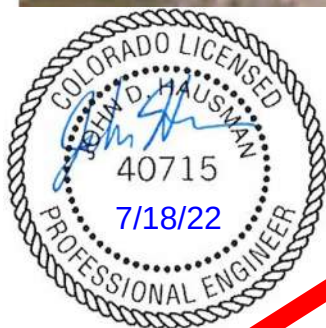

E. Mississippi Avenue

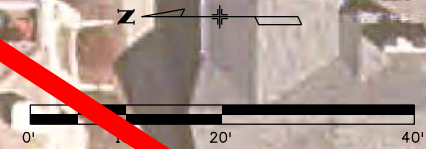

Print Date: 7/5/2022
Drawing File Name: 20005_SS4TRAF_Ped-Mississippi Civil.dgn
Horiz. Scale: 1"=20' Vert. Scale: As Noted

MULLER
ENGINEERING COMPANY

Sheet Revisions		
Date:	Comments	Init.



As Constructed		E. MISSISSIPPI AVENUE & S. DOWNING STREET CIVIL PLAN			
No Revisions:					
Revised:		Designer: AJL	Structure Numbers	Sheet Number 13	
Void:		Detailer: MAB			
		Sheet Subset: MISSISSIPPI	Subset Sheets: 3 of 4		

6/13/2022 5:57:00 PM P:\2020 Projects\20-005\01 Ped Intersection Program Development\20005\Traffic_ITS\Drawings\Alameda-Mississippi\Osage-Wolff Plan Package\20005_SS4TRAF_Ped-Mississippi Truck Turning Template.dgn
CDOT-DefaultPrinter_V8.plt
CDOT V81 Signals.tbl



Print Date: 6/13/2022
Drawing File Name: 20005_SS4TRAF_Ped-Mississippi Truck Turning Template.dgn
Horiz. Scale: 1"=40' Vert. Scale: As Noted



Sheet Revisions

Date:	Comments	Init.



As Constructed

No Revisions:

Revised:

Void:


E. MISSISSIPPI AVENUE & S. DOWNING STREET CCD FIRE TRUCK TURNING TEMPLATE

Designer:	AJL	Structure Numbers		Sheet Number 14
Detailer:	MAB			
Sheet Subset:	MISSISSIPPI	Subset Sheets:	4 of 4	

6/13/2022 12:18:30 PM P:\2020 Projects\2005.01 Ped Intersection Program Development\2005\Traffic_ITS\Drawings\Alameda-Mississippi-Osage-Wolff Plan Package\2005_SS4TRAF_Ped_11th-13th Charter School.dgn
CDOT V&I Signage



Increased spacing for flex posts in updating to the Denver complete streets planning and design approach memo (Typ.) - RV 6/5/25

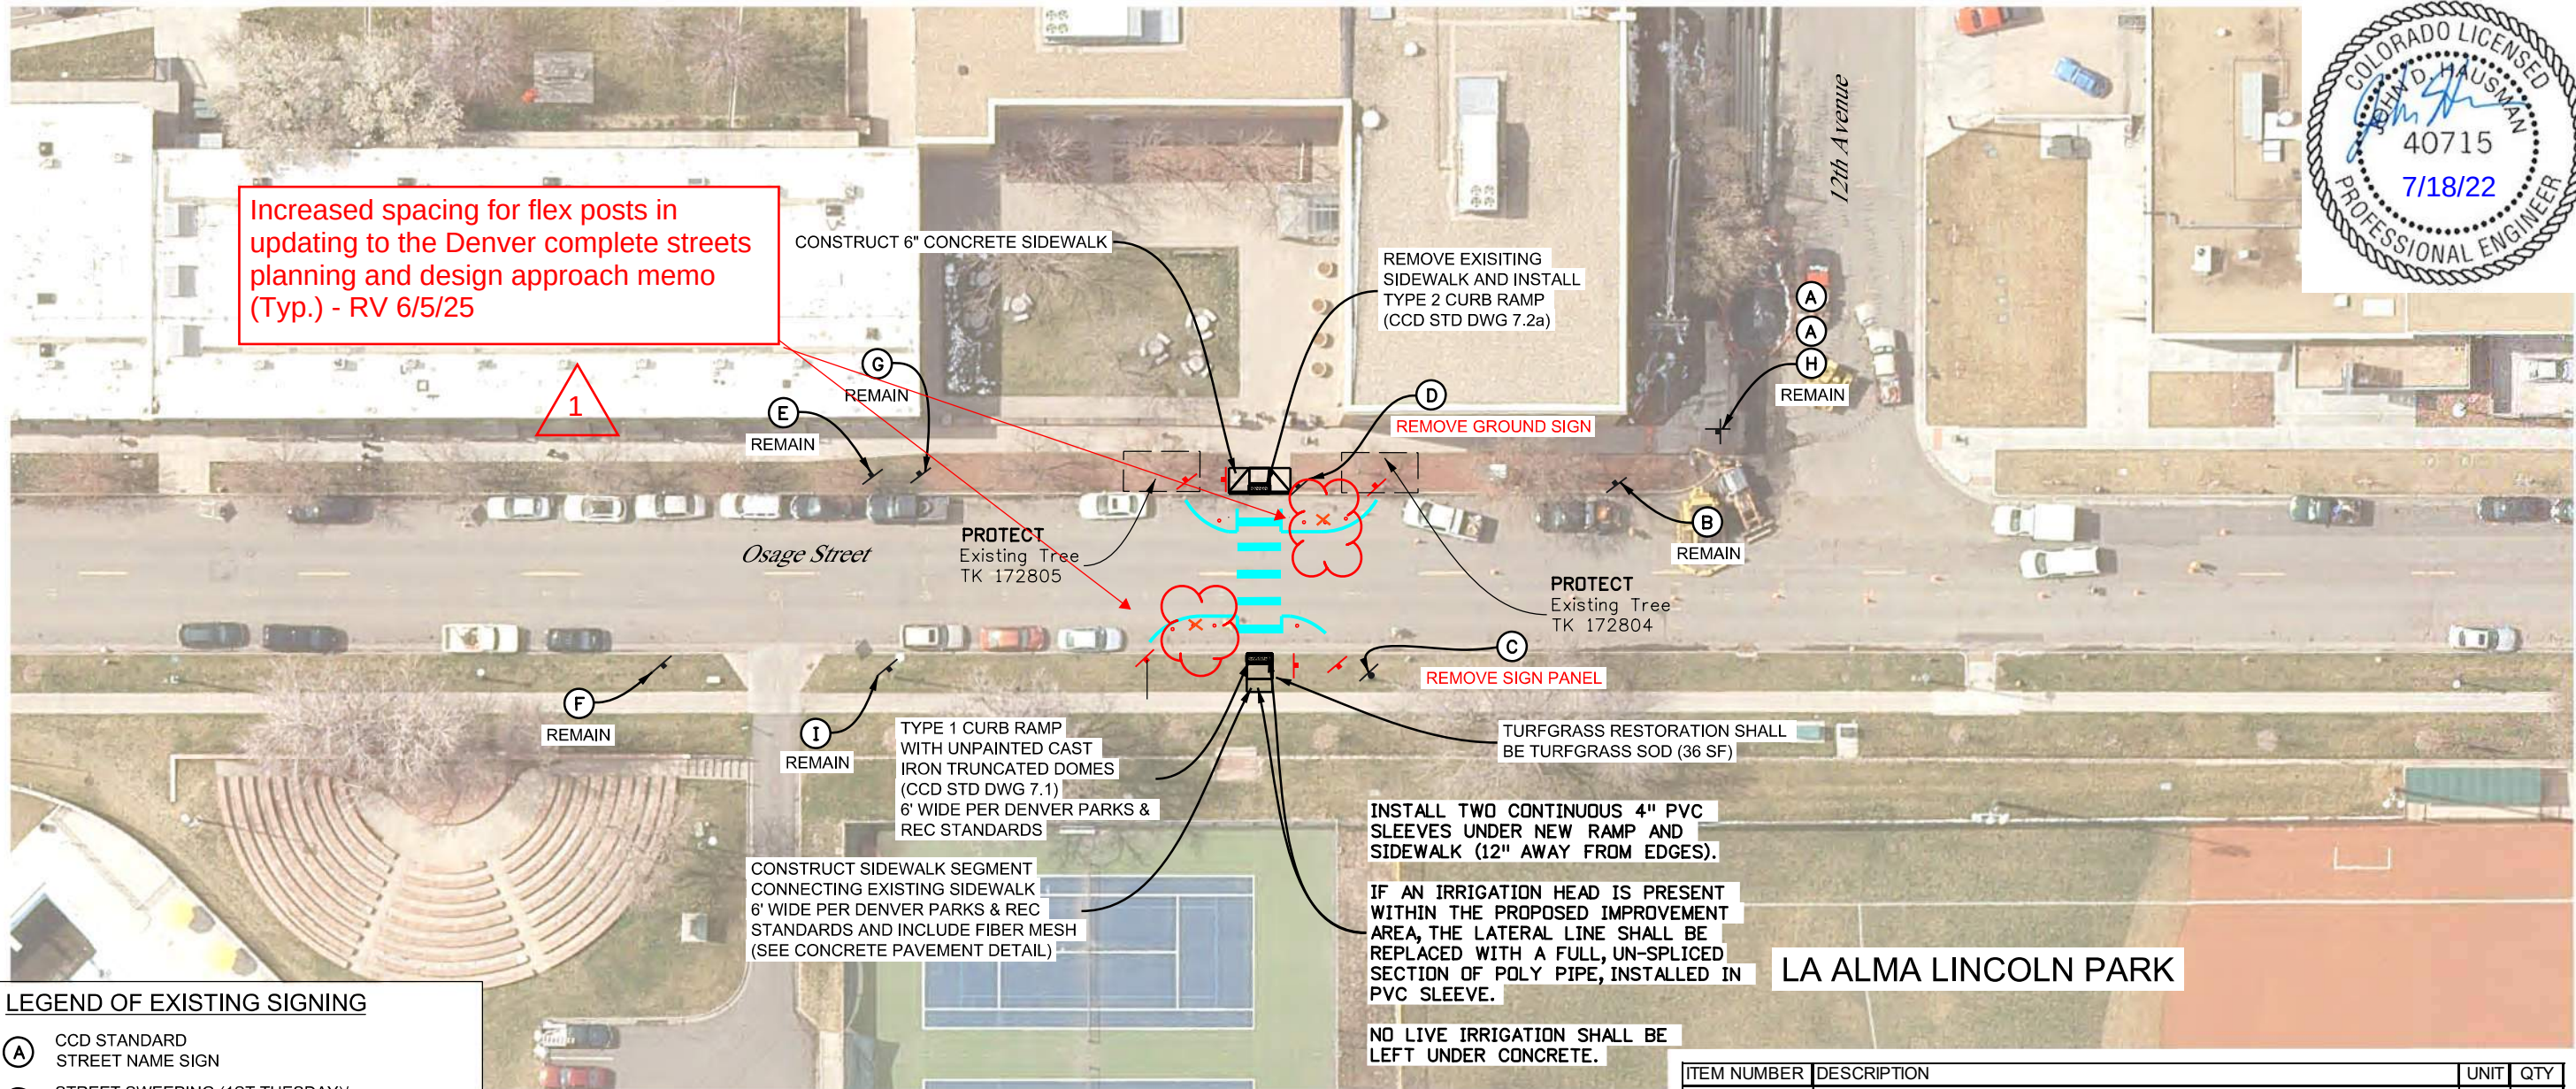

LEGEND OF EXISTING SIGNING

- (A) CCD STANDARD STREET NAME SIGN
- (B) STREET SWEEPING (1ST TUESDAY)/NO PARKING (RIGHT) (24R735A/10AR)
- (C) STREET SWEEPING (1ST WEDNESDAY) (12R7-35B)
- (D) LOADING ONLY (LEFT)/STREET SWEEPING (1ST TUESDAY) (24R7-166L/35A)
- (E) STREET SWEEPING (1ST TUESDAY)/RESERVED PARKING (RIGHT) (24SR7-35A/8R)
- (F) NO PARKING (LEFT) (12SR7-10AL)
- (G) RESERVED PARKING (LEFT)/LOADING ONLY (RIGHT) (24SR7-8L/166R)
- (H) STOP SIGN (R1-1)
- (I) STREET SWEEPING (1ST WEDNESDAY)/NO PARKING RIGHT (24R7-35B/10AR)


CONSTRUCTION NOTES:

1. INSTALL CITY POSTS 2' INSIDE STRIPING AT 5' SPACING UNLESS OTHERWISE NOTED. FIELD FIT TO AVOID GUTTER PAN. SEE DETAIL FOR MORE INFORMATION.
2. ALL EXISTING SIGNS SHALL BE PROTECTED IN PLACE UNLESS OTHERWISE NOTED.
3. REFER TO DENVER TRAFFIC SIGNAL, SIGN AND PAVEMENT MARKING STANDARDS FOR INFORMATION ON PAVEMENT MARKINGS AND CITY POSTS.
4. PROJECT MANAGER TO CONFIRM ALL PROPOSED SIGN LOCATIONS.
5. ALL RADII ARE 15' UNLESS OTHERWISE NOTED.
6. EXISTING SIGNS THAT ARE RESET WILL HAVE THE EXISTING POLE REMOVED AND WILL BE INSTALLED ON A NEW POLE UNLESS OTHERWISE NOTED.
7. DIMENSIONS GIVEN FROM FLOWLINE AND CENTER OF STRIPING UNLESS OTHERWISE NOTED.

LEGEND

- CITY POST (TYPE C)
- † SIGN PROPOSED
- ‡ SIGN EXISTING
- ◊ EXISTING SIGN ON EXISTING POLE

ITEM NUMBER	DESCRIPTION	UNIT	QTY
202-00200	REMOVAL OF SIDEWALK	SY	9
202-00203	REMOVAL OF CURB AND GUTTER	LF	21
202-00810	REMOVAL OF GROUND SIGN	EA	1
202-00821	REMOVAL OF SIGN PANEL	EA	1
212-00050	SOD	SF	36
604	4" PVC SLEEVE	LF	12
608-00006	CONCRETE SIDEWALK (6 INCH)	SY	5.5
608-00010	CONCRETE CURB RAMP	SY	11
614-00011	SIGN PANEL (CLASS 1)	SF	92
614-00216	STEEL SIGN POST (2X2 INCH TUBING)	LF	120
627-00005	MODIFIED EPOXY PAVEMENT MARKING	GAL	2
627-30410	PREFORMED THERMOPLASTIC PAVEMENT MARKING (X-WALK/STOP LINE)	SF	75
627-70038	RAISED PAVEMENT MARKER "CITY POSTS" (ASPHALT INSTALLATION)(WHITE)	EA	8

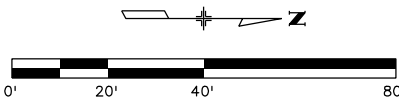

Print Date: 6/13/2022
Drawing File Name: 20005_SS4TRAF_Ped_11th-13th Charter School.dgn
Horiz. Scale: 1:40
Vert. Scale: As Noted



Sheet Revisions

Date:	Comments	Init.



As Constructed

No Revisions:

Revised:

Void:

OSAGE STREET - CHARTER SCHOOLS
CROSSWALK LAYOUT

Designer:	AJL	Structure Numbers	
Detailer:	MAB		
Sheet Subset:	OSAGE	Subset Sheets:	1 of 3

Sheet Number

15


alition 12/21/18 PM, P:\2020 Projects\20005.01 Ped Intersection Program Development\200051Traffic_ITS\Drawings\Alameda-Mississippi-Osage-Wolff Plan Package\20005_SS4TRAF_Ped_11th-13th Charter School Detail.dgn
CDOT Default Inter_V8.plt
6/13/2022

LEGEND:

- CITY POSTS (TYPE C)
- SIGN PROPOSED — SIGN EXISTING
- 8 8" SOLID WHITE RIGHT EDGE LINE OR TURN LANE LINE
- 16 18"x10' WHITE CROSSWALK BAR



NOTE:
COORDINATE WITH DENVER PARKS AND RECREATION
FOR PLACEMENT OF ALL GROUND SIGNS WITHIN
LA ALMA LINCOLN

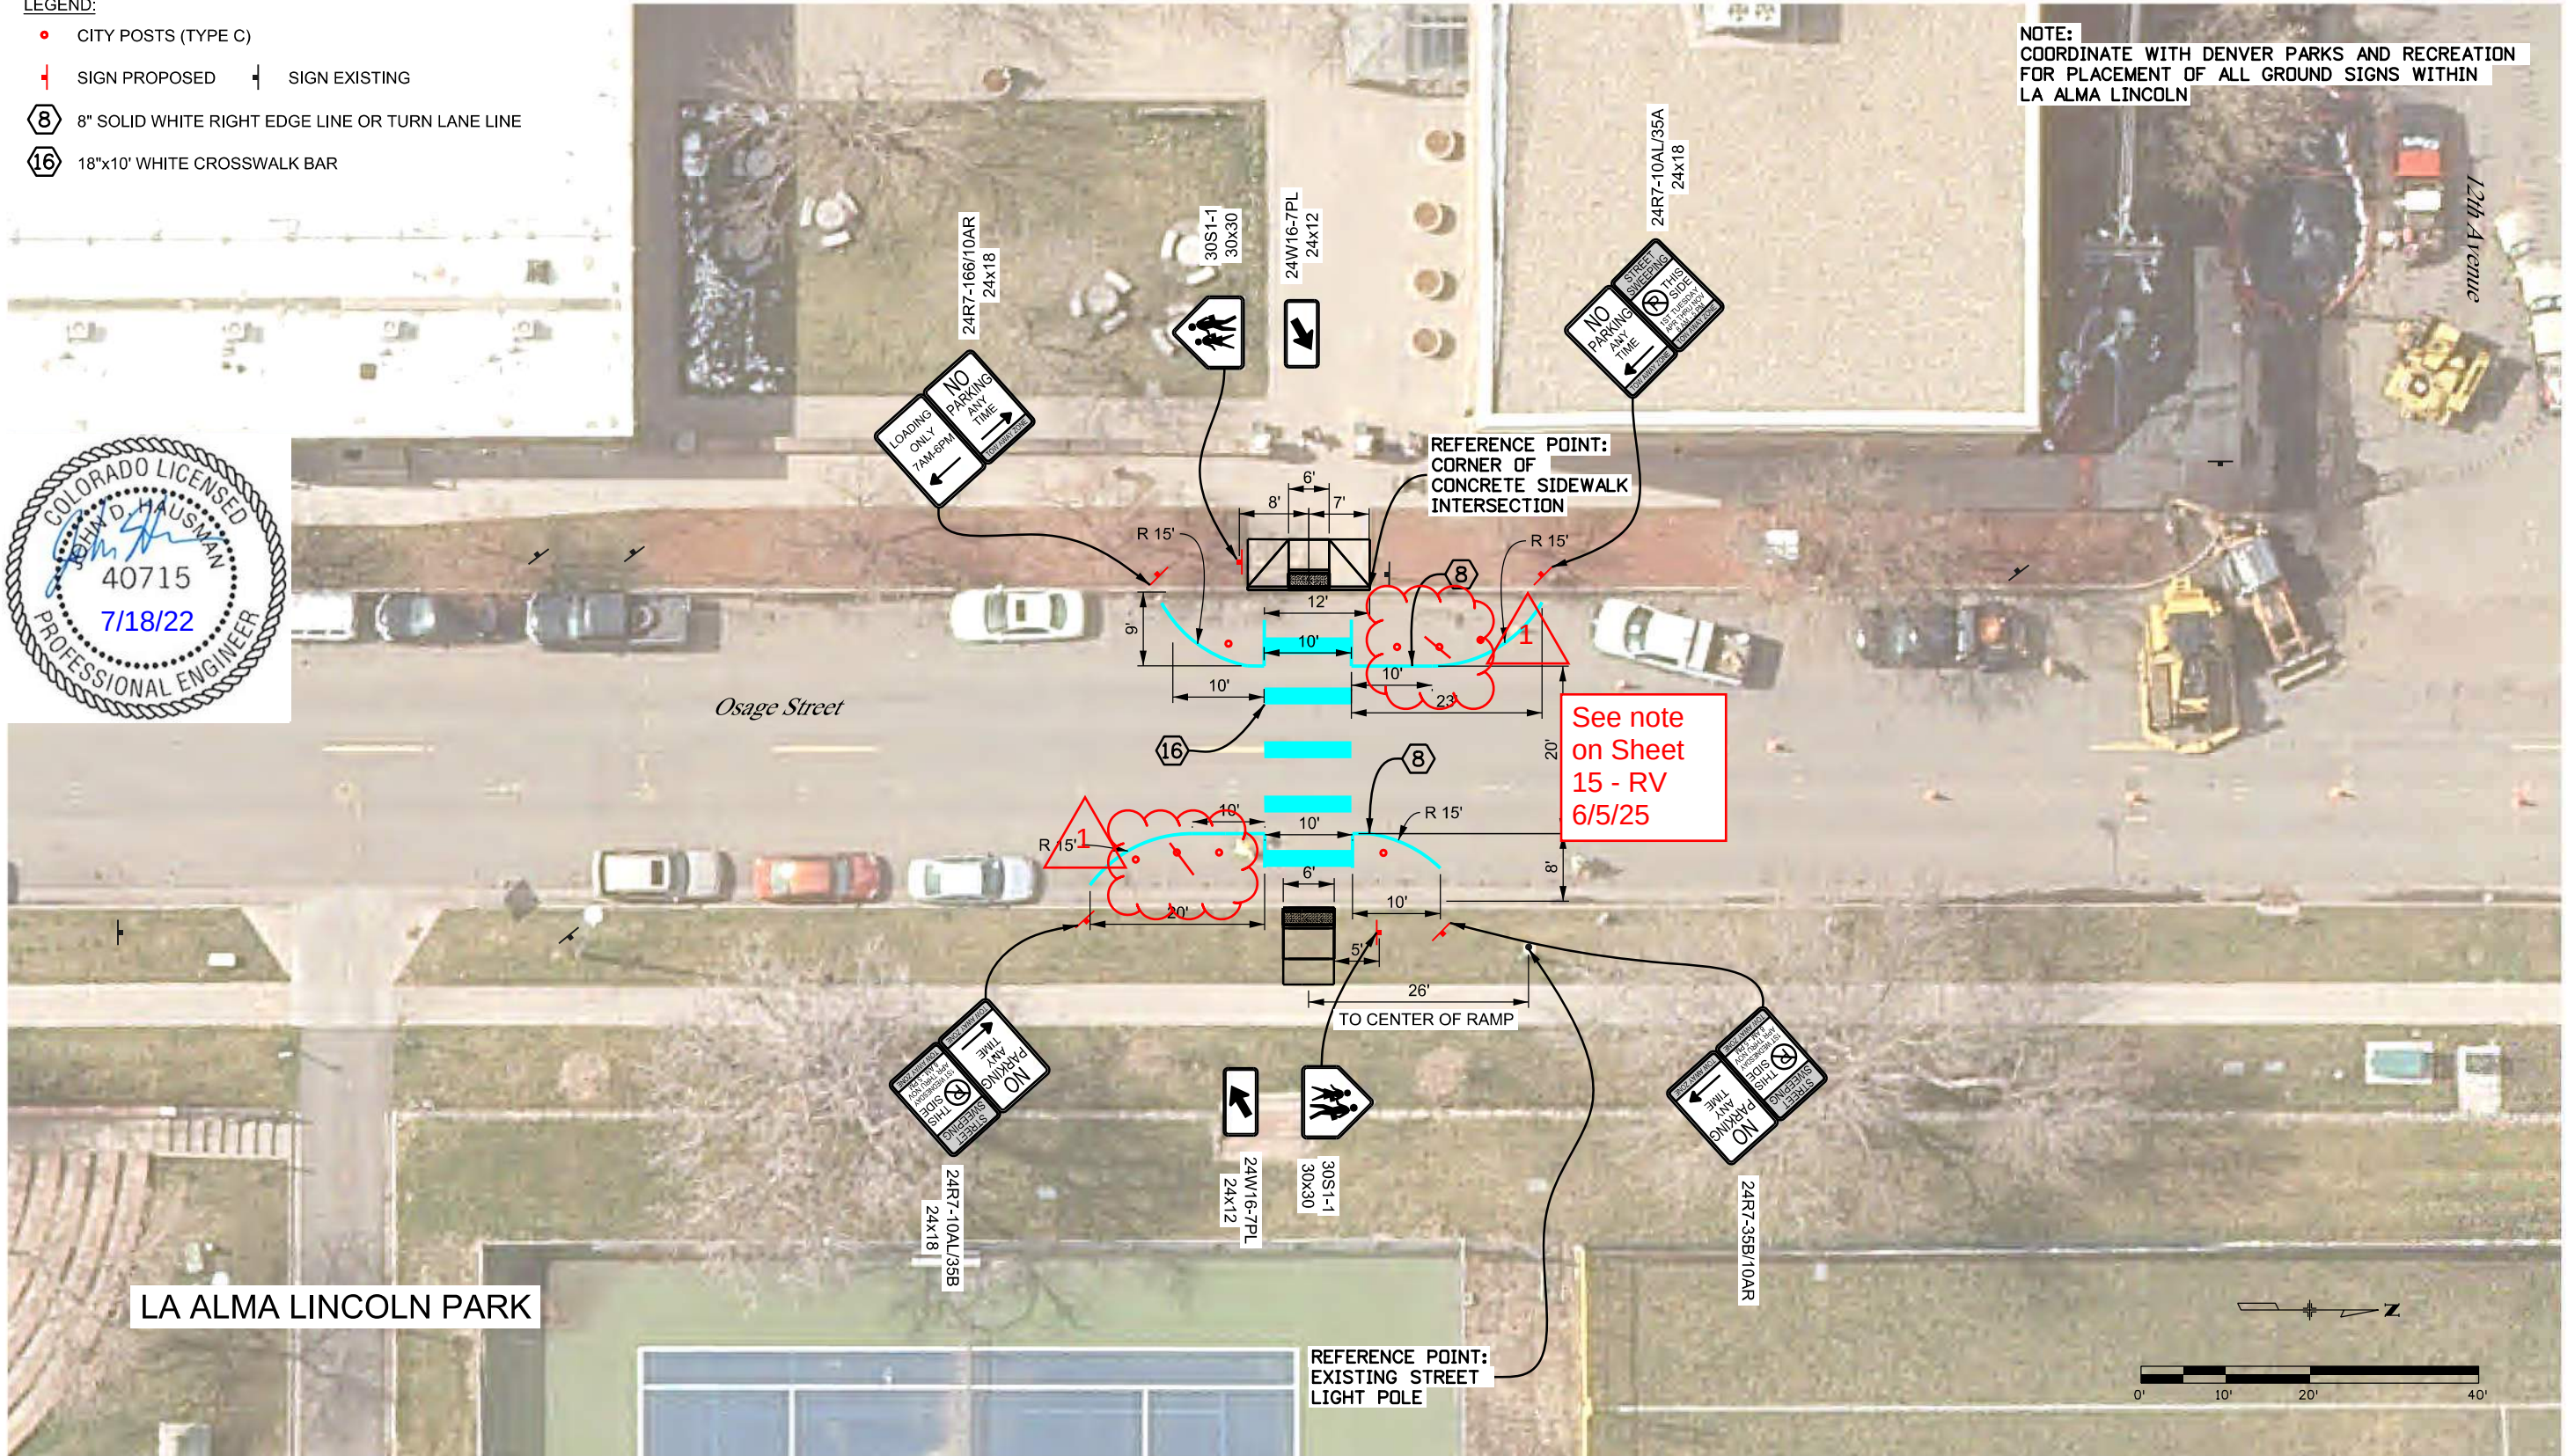

Print Date: 6/13/2022
Drawing File Name: 20005_SS4TRAF_Ped_11th-13th Charter School Detail.dgn
Horiz. Scale: 1:20 Vert. Scale: As Noted



0000

Sheet Revisions		
Date:	Comments	Init.



As Constructed

No Revisions:



Revised:

Void:

OSAGE STREET - CHARTER SCHOOLS CROSSWALK
INTERSECTION DETAIL


Designer:	AJL	Structure		Sheet Number 16
Detailer:	MAB	Numbers		
Sheet Subset:	OSAGE	Subset Sheets:	2 OF 3	

Revision 12/28/22 PM P:\2020 Projects\20005.01 Ped Intersection Program Development\20005\Traffic_ITS\Drawings\Alameda-Mississippi-Osage-Wolff Plan Package\20005_SS4TRAF_Ped_11th-13th - Osage.dgn
CDOT-Default\Printer_V8i.plt
CDOT V8i Signage.tbl

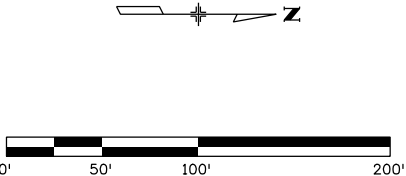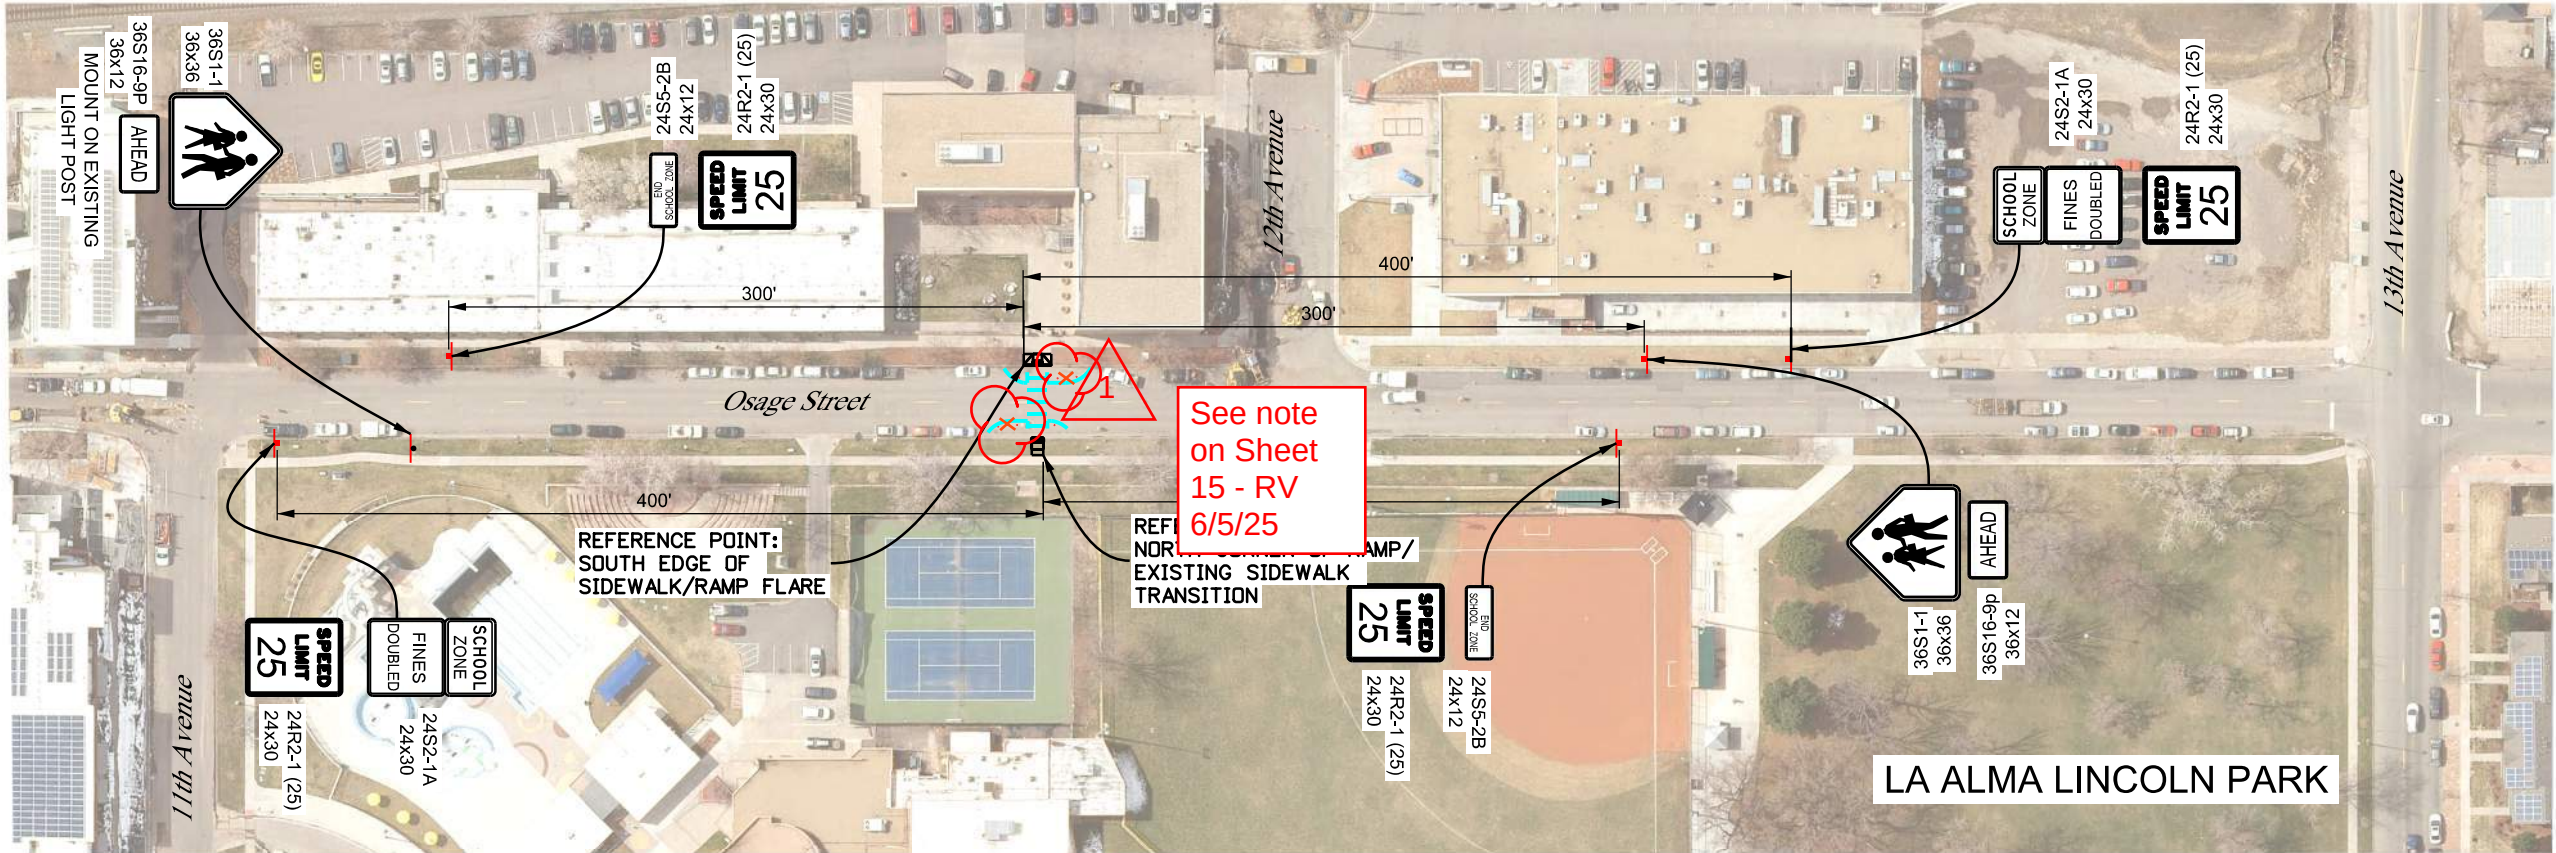

Print Date: 6/13/2022		0000	Sheet Revisions				As Constructed		OSAGE STREET - 11TH TO 13TH SCHOOL ZONE SIGNING			
Drawing File Name: 20005_SS4TRAF_Ped_11th-13th - Osage.dgn			Date:	Comments	Init.		No Revisions:					
Horiz. Scale: 1:100 Vert. Scale: As Noted							Revised:		Designer: AJL	Structure Numbers	Sheet Number	
							Void:		Detailer: MAB			
							Sheet Subset: OSAGE		Subset Sheets: 3 of 3		17	

sl:\proj\2020\Projects\20200501 Ped Intersection Program Development\20005\Traffic\ITS\Drawings\Alameda-Mississippi-Osage-Wolff Plan Package\20005_SS4TRAF_Ped-Wolff.dgn
7/18/2022
CDOT-DefaultPrinter_V8.plt

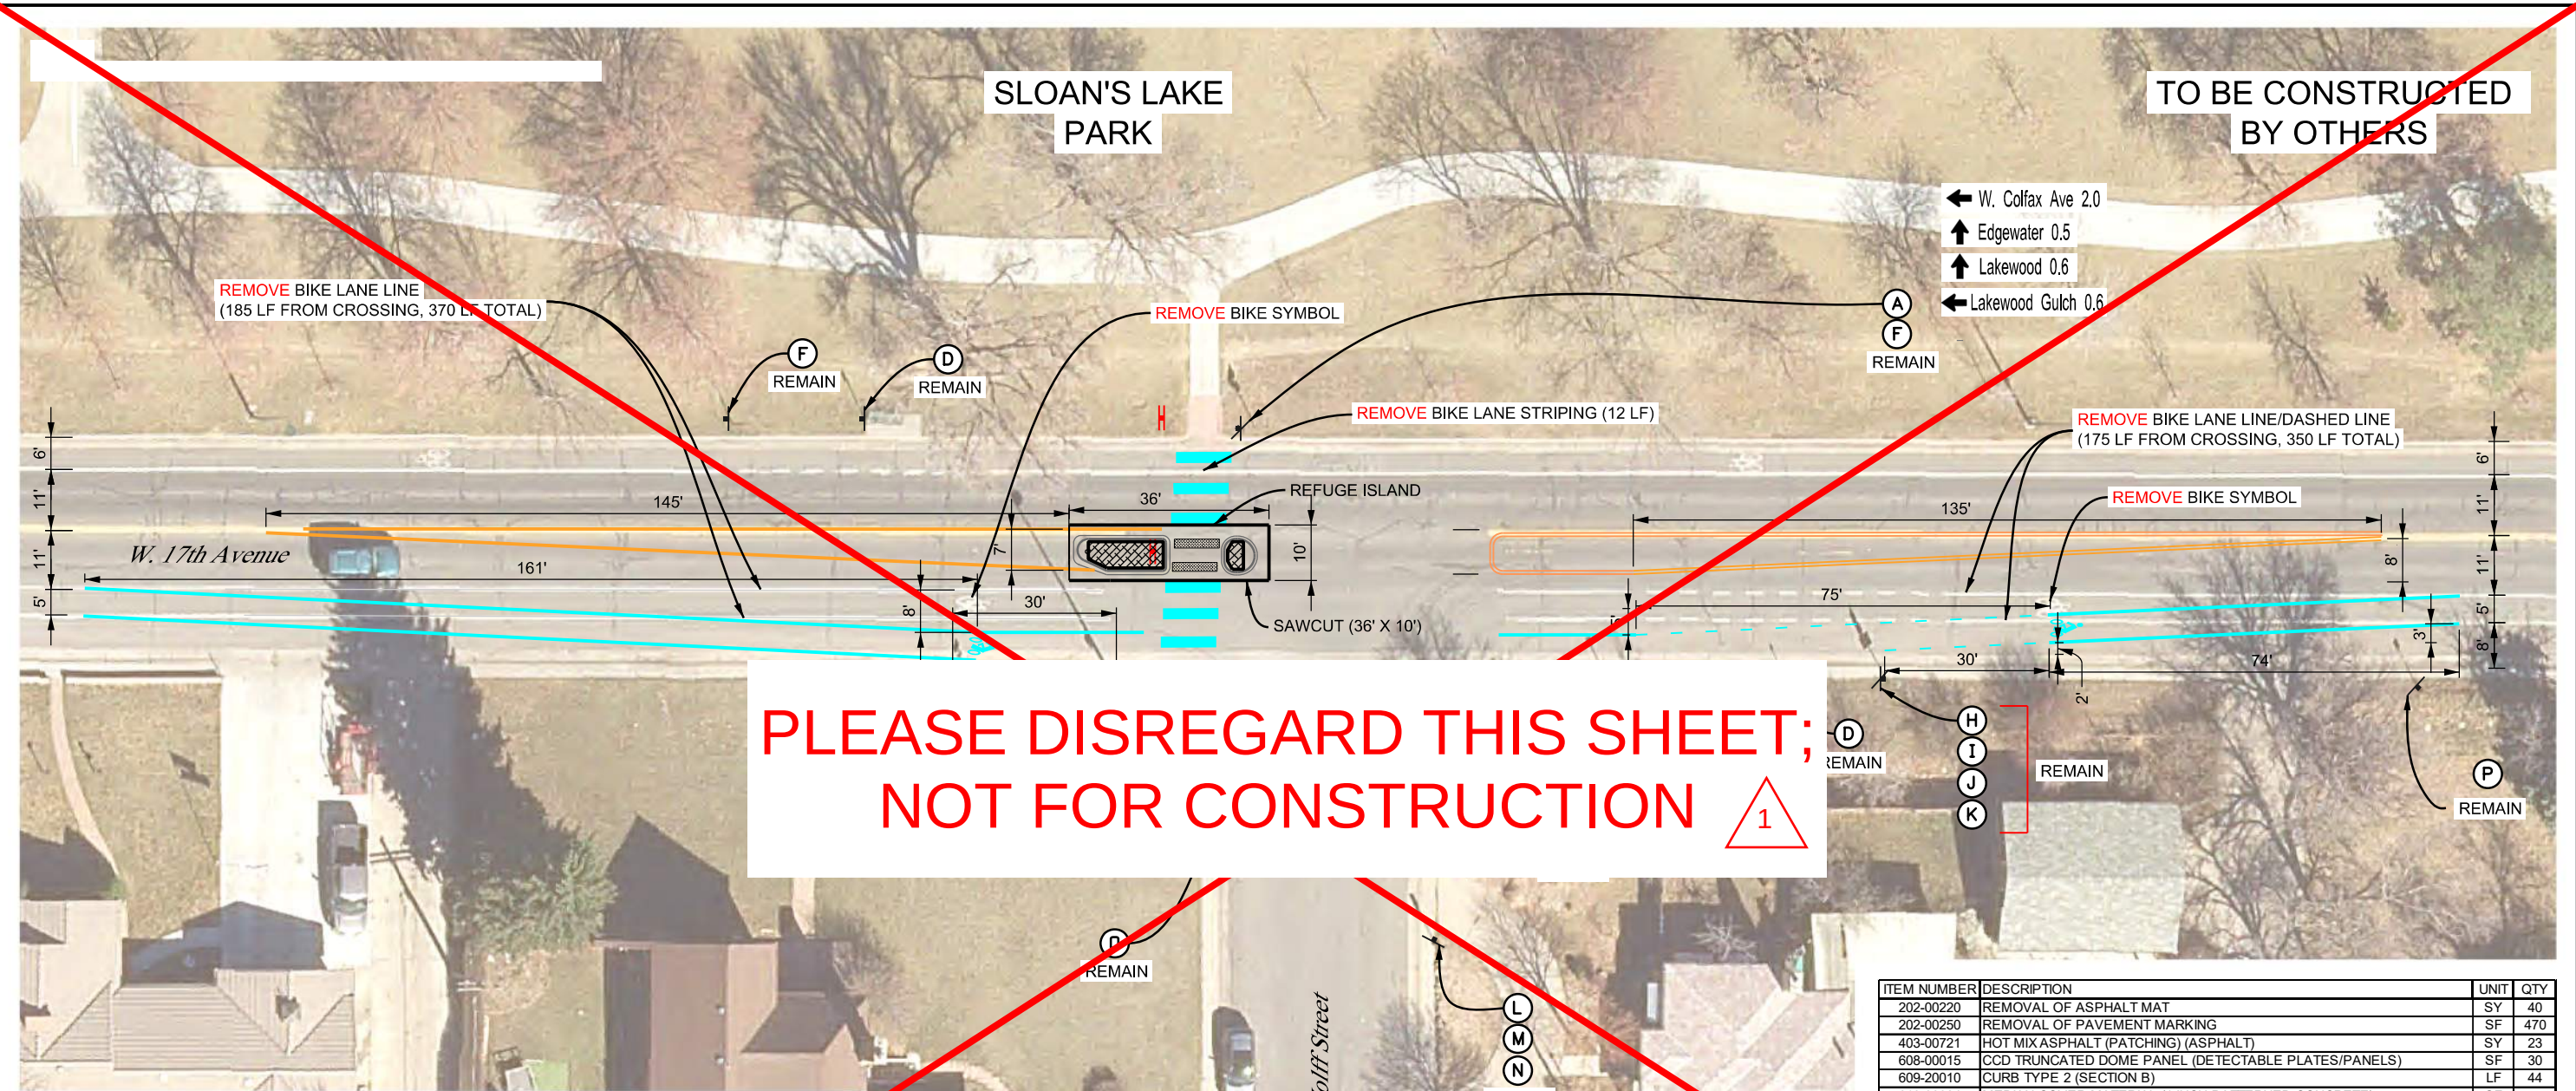


LEGEND OF EXISTING SIGNING	
(A) WAYFINDING SIGN (D1-3A)	(I) NO TRUCKS (R5-2)
(B) STREET NAME SIGN (D3-1)	(J) NO PARKING 3RD THURSDAY (SR7-36(K))
(C) STOP SIGN (R1-1)	(K) TWO-HOUR PARKING/NO PARKING (RIGHT) (24R7-(SPECIAL) 10 AR)
(D) BUS STOP	(L) BIKE ROUTE SIGN (M1-8(D8))
(E) BIKE LANE (R3-17)	(M) STRAIGHT/RIGHT ARROW (M2-6)
(F) TOW AWAY PARKING ZONE (12R7-10A)	(N) NO PARKING (LEFT)/STREET SWEEPING 3RD TUESDAY (24R7-10AL/35I)
(G) NO PARKING (LEFT)/ STREET SWEEPING 3RD THURSDAY (24R7-10AL/35K)	(O) STREET SWEEPING 3RD WEDNESDAY/NO PARKING (RIGHT) (24R7-35J/10AR)
(H) SPEED LIMIT SIGN (R2-1(30))	(P) NO PARKING 3RD THURSDAY/NO PARKING SAT/SUN & HOLIDAYS (CR7-12(CUSTOM))

CONSTRUCTION NOTES:

1. ALL EXISTING SIGNS SHALL BE PROTECTED IN PLACE UNLESS OTHERWISE NOTED.
2. REFER TO DENVER TRAFFIC SIGNAL, SIGN AND PAVEMENT MARKING STANDARDS FOR INFORMATION ON PAVEMENT MARKINGS AND CITY POSTS.
3. PROJECT MANAGER TO CONFIRM ALL PROPOSED SIGN LOCATIONS.
4. EXISTING SIGNS THAT ARE RESET WILL HAVE THE EXISTING POLE REMOVED AND WILL BE INSTALLED ON A NEW POLE UNLESS OTHERWISE NOTED.
5. DIMENSIONS GIVEN FROM FLOWLINE AND CENTER OF STRIPING UNLESS OTHERWISE NOTED.

LEGEND

— SIGN PROPOSED — SIGN EXISTING

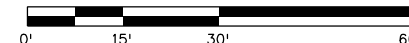

ITEM NUMBER	DESCRIPTION	UNIT	QTY
202-00220	REMOVAL OF ASPHALT MAT	SY	40
202-00250	REMOVAL OF PAVEMENT MARKING	SF	470
403-00721	HOT MIX ASPHALT (PATCHING) (ASPHALT)	SY	23
608-00015	CCD TRUNCATED DOME PANEL (DETECTABLE PLATES/PANELS)	SF	30
609-20010	CURB TYPE 2 (SECTION B)	LF	44
610-00024	MEDIAN COVER MATERIAL (4 INCH PATTERNED CONCRETE)	SF	75
614-00011	SIGN PANEL (CLASS I)	SF	48
614-00216	STEEL SIGN POST (2X2 INCH TUBING)	LF	20
627-00005	MODIFIED EPOXY PAVEMENT MARKING	GAL	6
627-30405	PREFORMED THERMOPLASTIC PAVEMENT MARKING (WORD-SYMBOL)	SF	24
627-30410	PREFORMED THERMOPLASTIC PAVEMENT MARKING (X-WALK/STOP LINE)	SF	214



Print Date: 7/18/2022
Drawing File Name: 20005_SS4TRAF_Ped-Wolff.dgn
Horiz. Scale: 1:30 Vert. Scale: As Noted



Sheet Revisions

Date:	Comments	Init.



As Constructed

No Revisions:

Revised:

Void:


WOLFF STREET & W.17TH AVENUE
SIGNING AND STRIPING REMOVALS

Designer:	AJL	Structure	
Detailer:	MAB	Numbers	
Sheet Subset:	WOLFF	Subset Sheets:	1 of 4

Sheet Number

18

slition 9/28/2020 AM 10:00:00 Projects\20005\01 Ped Intersection Program Development\20005\Traffic_ITS\Drawings\Alameda-Mississippi-Osage-Wolff Plan Package\20005_SS4TRAF_Ped-Wolff Detail.dgn
7/18/2022 CDOT-DefaultPrinter_V8i.plt

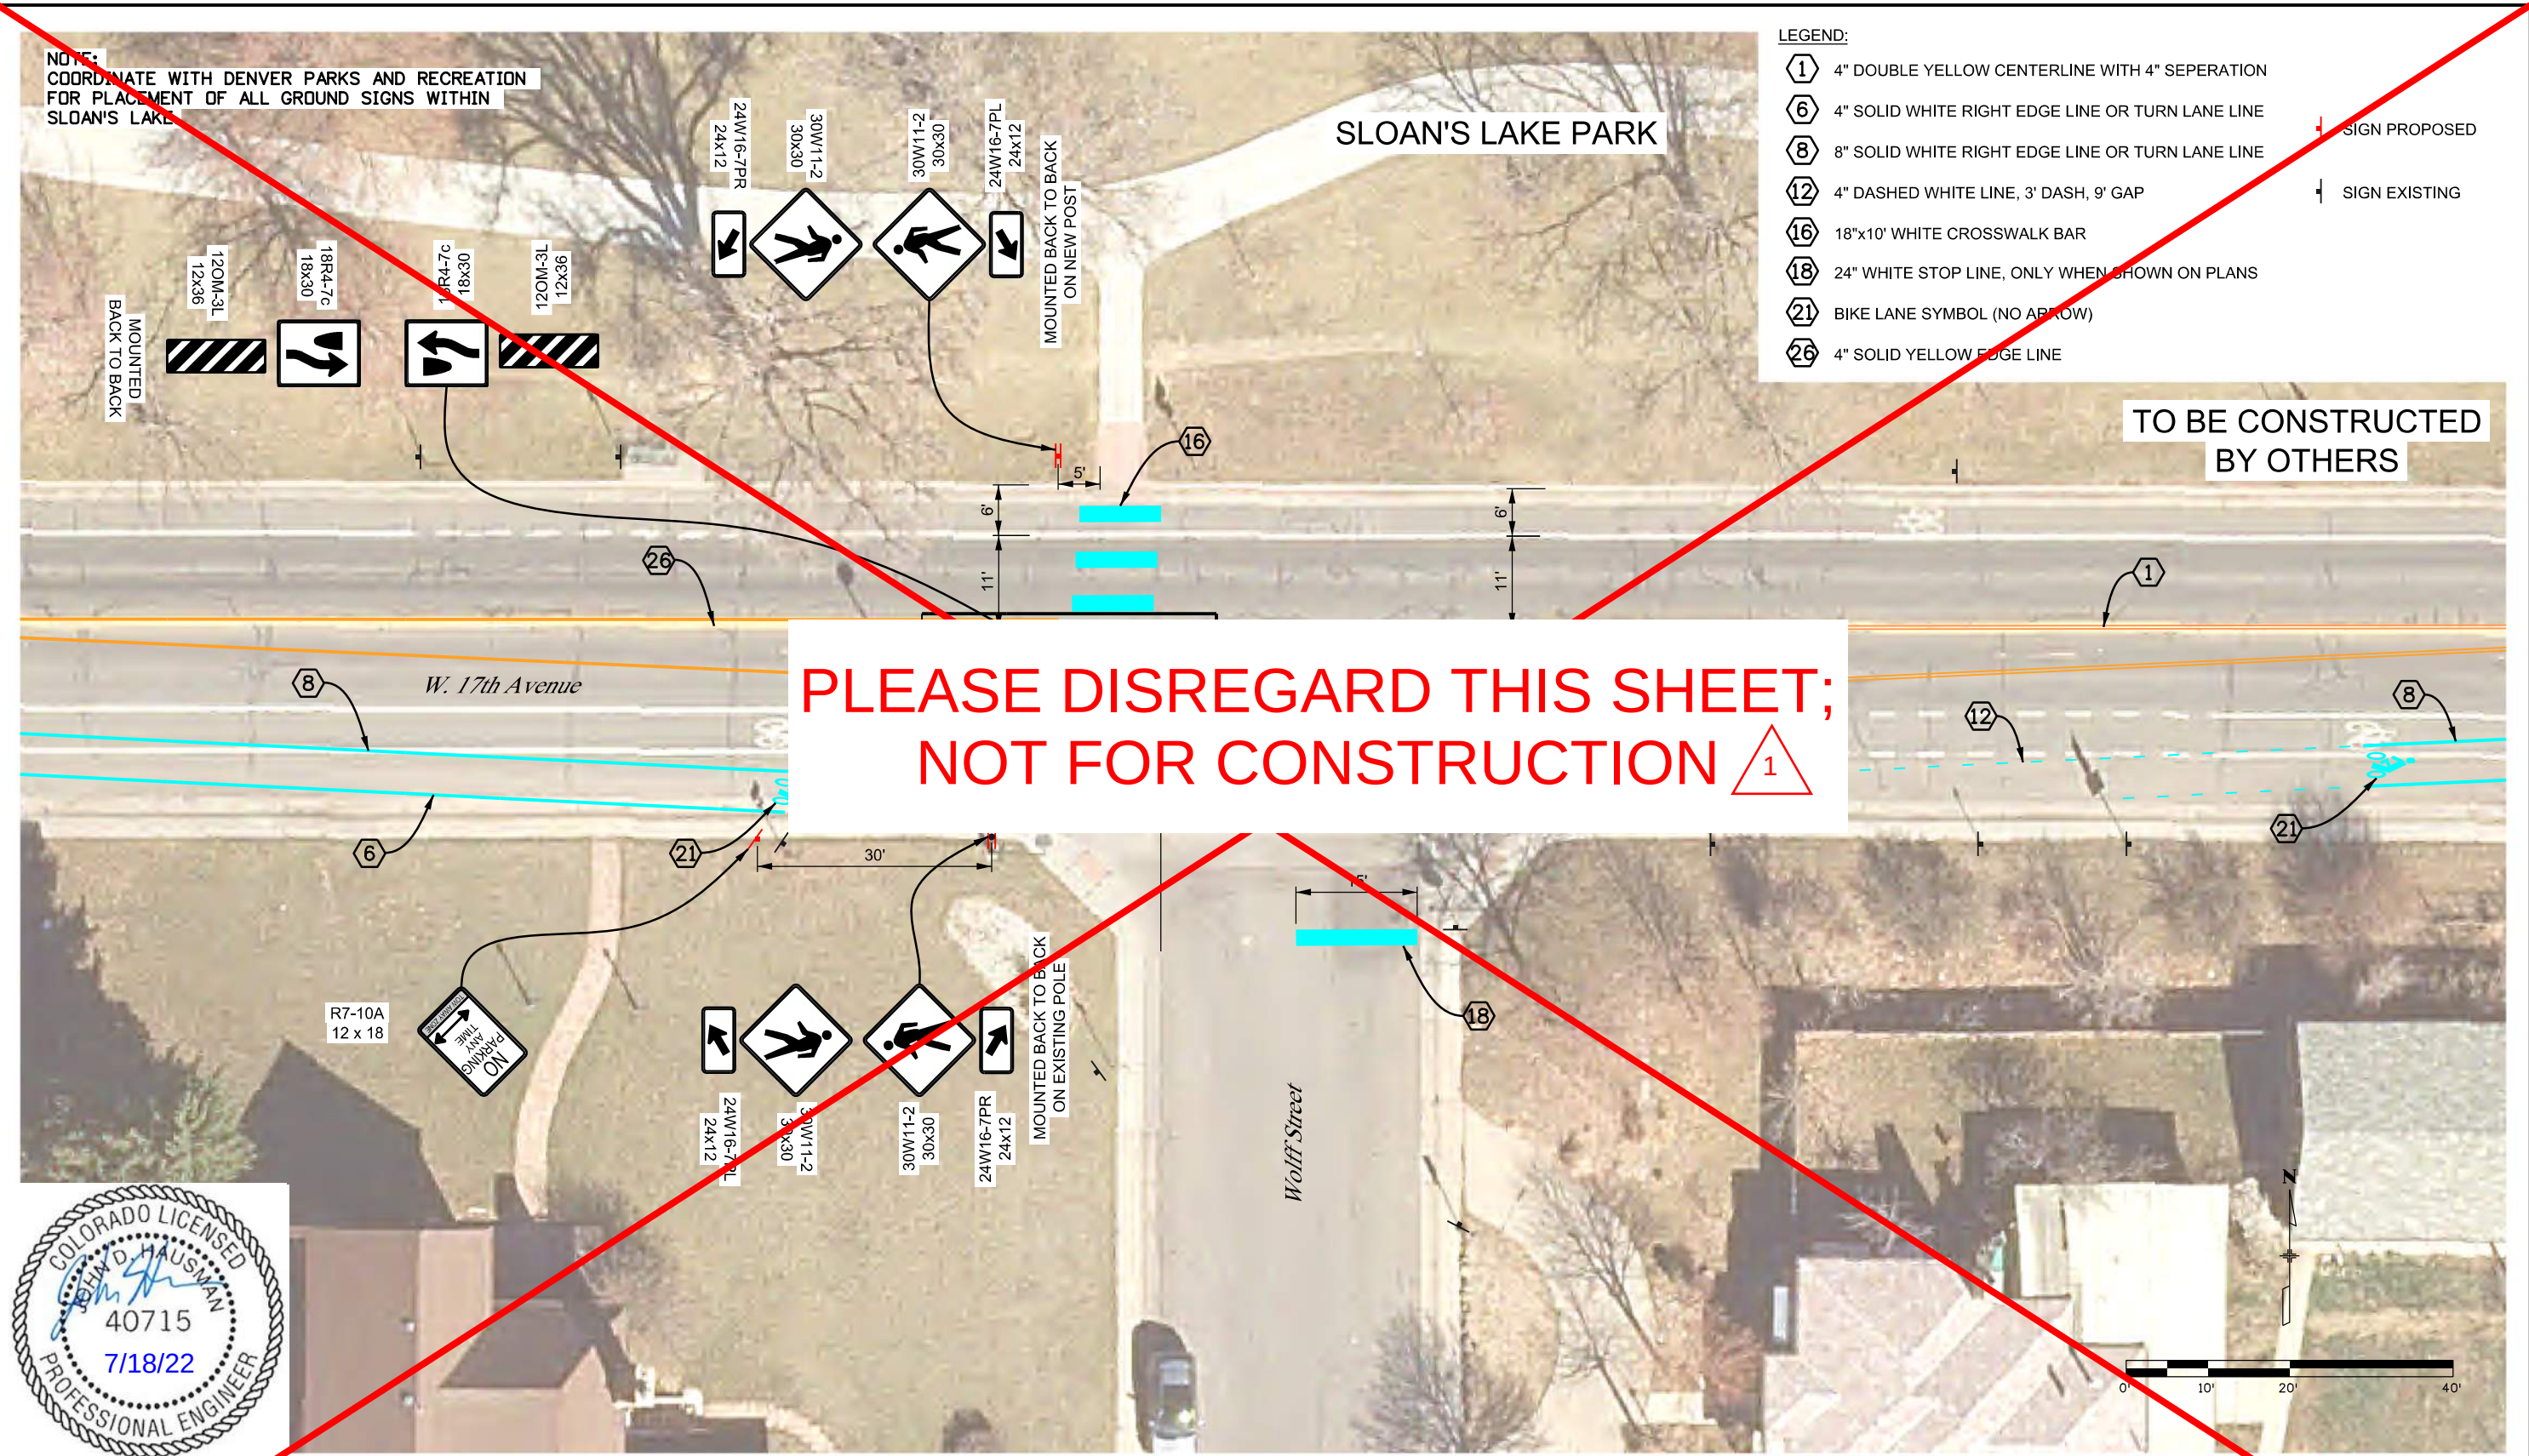

Print Date: 7/18/2022

Drawing File Name: 20005_SS4TRAF_Ped-Wolff Detail.dgn

Horiz. Scale: 1:20 Vert. Scale: As Noted



MULLER
ENGINEERING COMPANY

Sheet Revisions		
Date:	Comments	Init.

DENVER
TRANSPORTATION & INFRASTRUCTURE

As Constructed		WOLFF STREET & W.17TH AVENUE INTERSECTION DETAIL			
No Revisions:					
Revised:		Designer: AJL	Structure Numbers	Sheet Number	
Void:		Detailer: MAB			
		Sheet Subset: WOLFF	Subset Sheets: 2 of 4	19	

slition 9:37:40 AM P:\2020 Projects\20-005.01 Ped Intersection Program Development\2005\Traffic_ITS\Drawings\Alameda-Mississippi-Osage-Wolff Plan Package\2005_SS4TRAF_Ped-Wolff Civil.dgn
CDOT V81 Signage.tbl

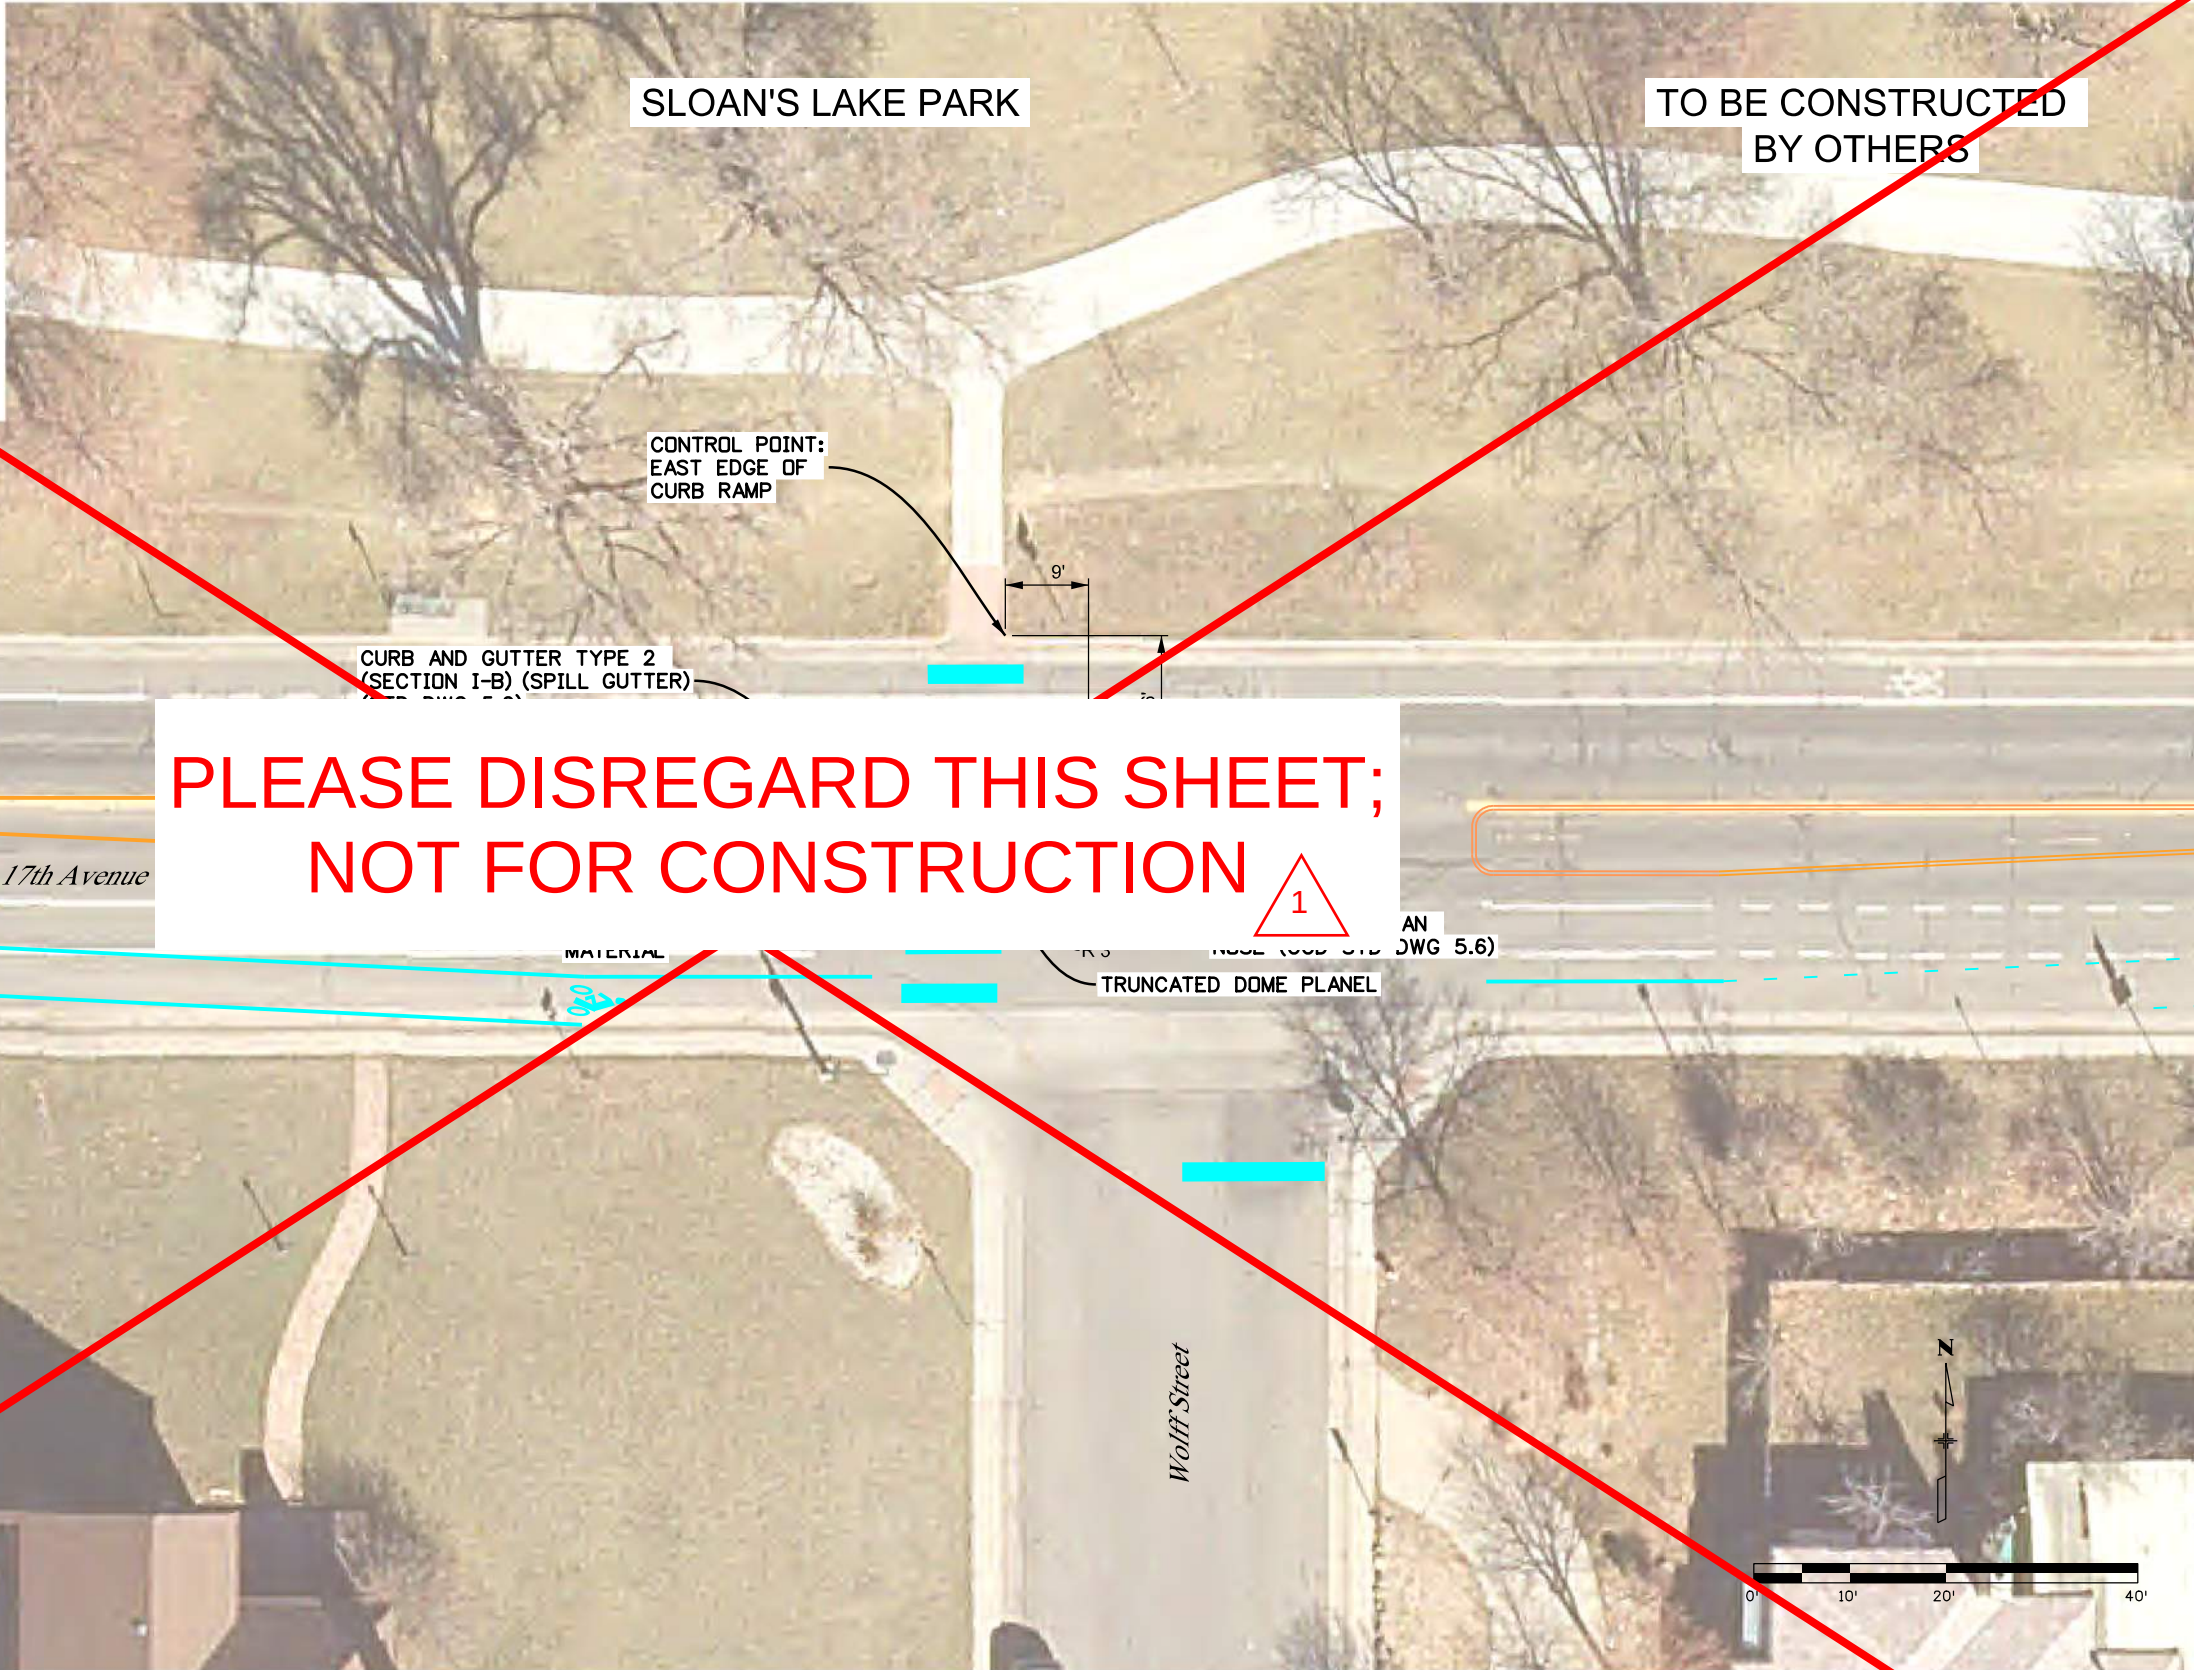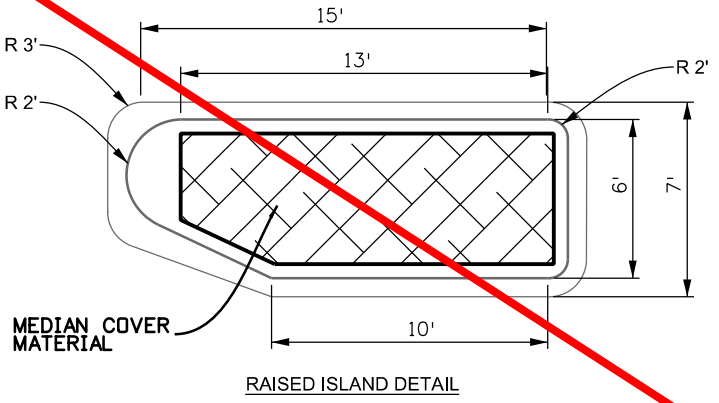

PLEASE DISREGARD THIS SHEET;
NOT FOR CONSTRUCTION



Print Date: 7/18/2022
Drawing File Name: 20005_SS4TRAF_Ped-Wolff Civil.dgn
Horiz. Scale: 1:20 Vert. Scale: As Noted

MULLER
ENGINEERING COMPANY




Sheet Revisions		
Date:	Comments	Init.

DENVER
TRANSPORTATION & INFRASTRUCTURE

As Constructed
No Revisions:
Revised:
Void:

WOLFF STREET & W.17TH AVENUE CIVIL PLAN			
Designer:	AJL	Structure	Sheet Number
Detailer:	MAB	Numbers	
Sheet Subset:	WOLFF	Subset Sheets: 3 of 4	
			20

slition 9:55:10 AM P:\2020 Projects\20-005\01 Ped Intersection Program Development\20005\Traffic_ITS\Drawings\Alameda-Mississippi-Osage-Wolff Plan Package\20005_SS4TRAF_Ped_Wolff Truck Turning Template.dgn
CDOT-DefaultPrinter_V8.plt
7/18/2022

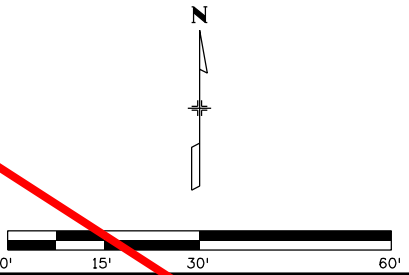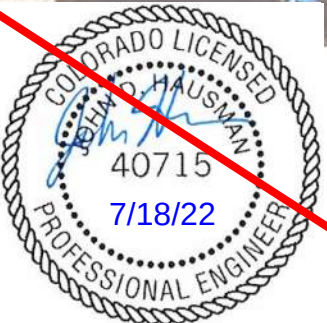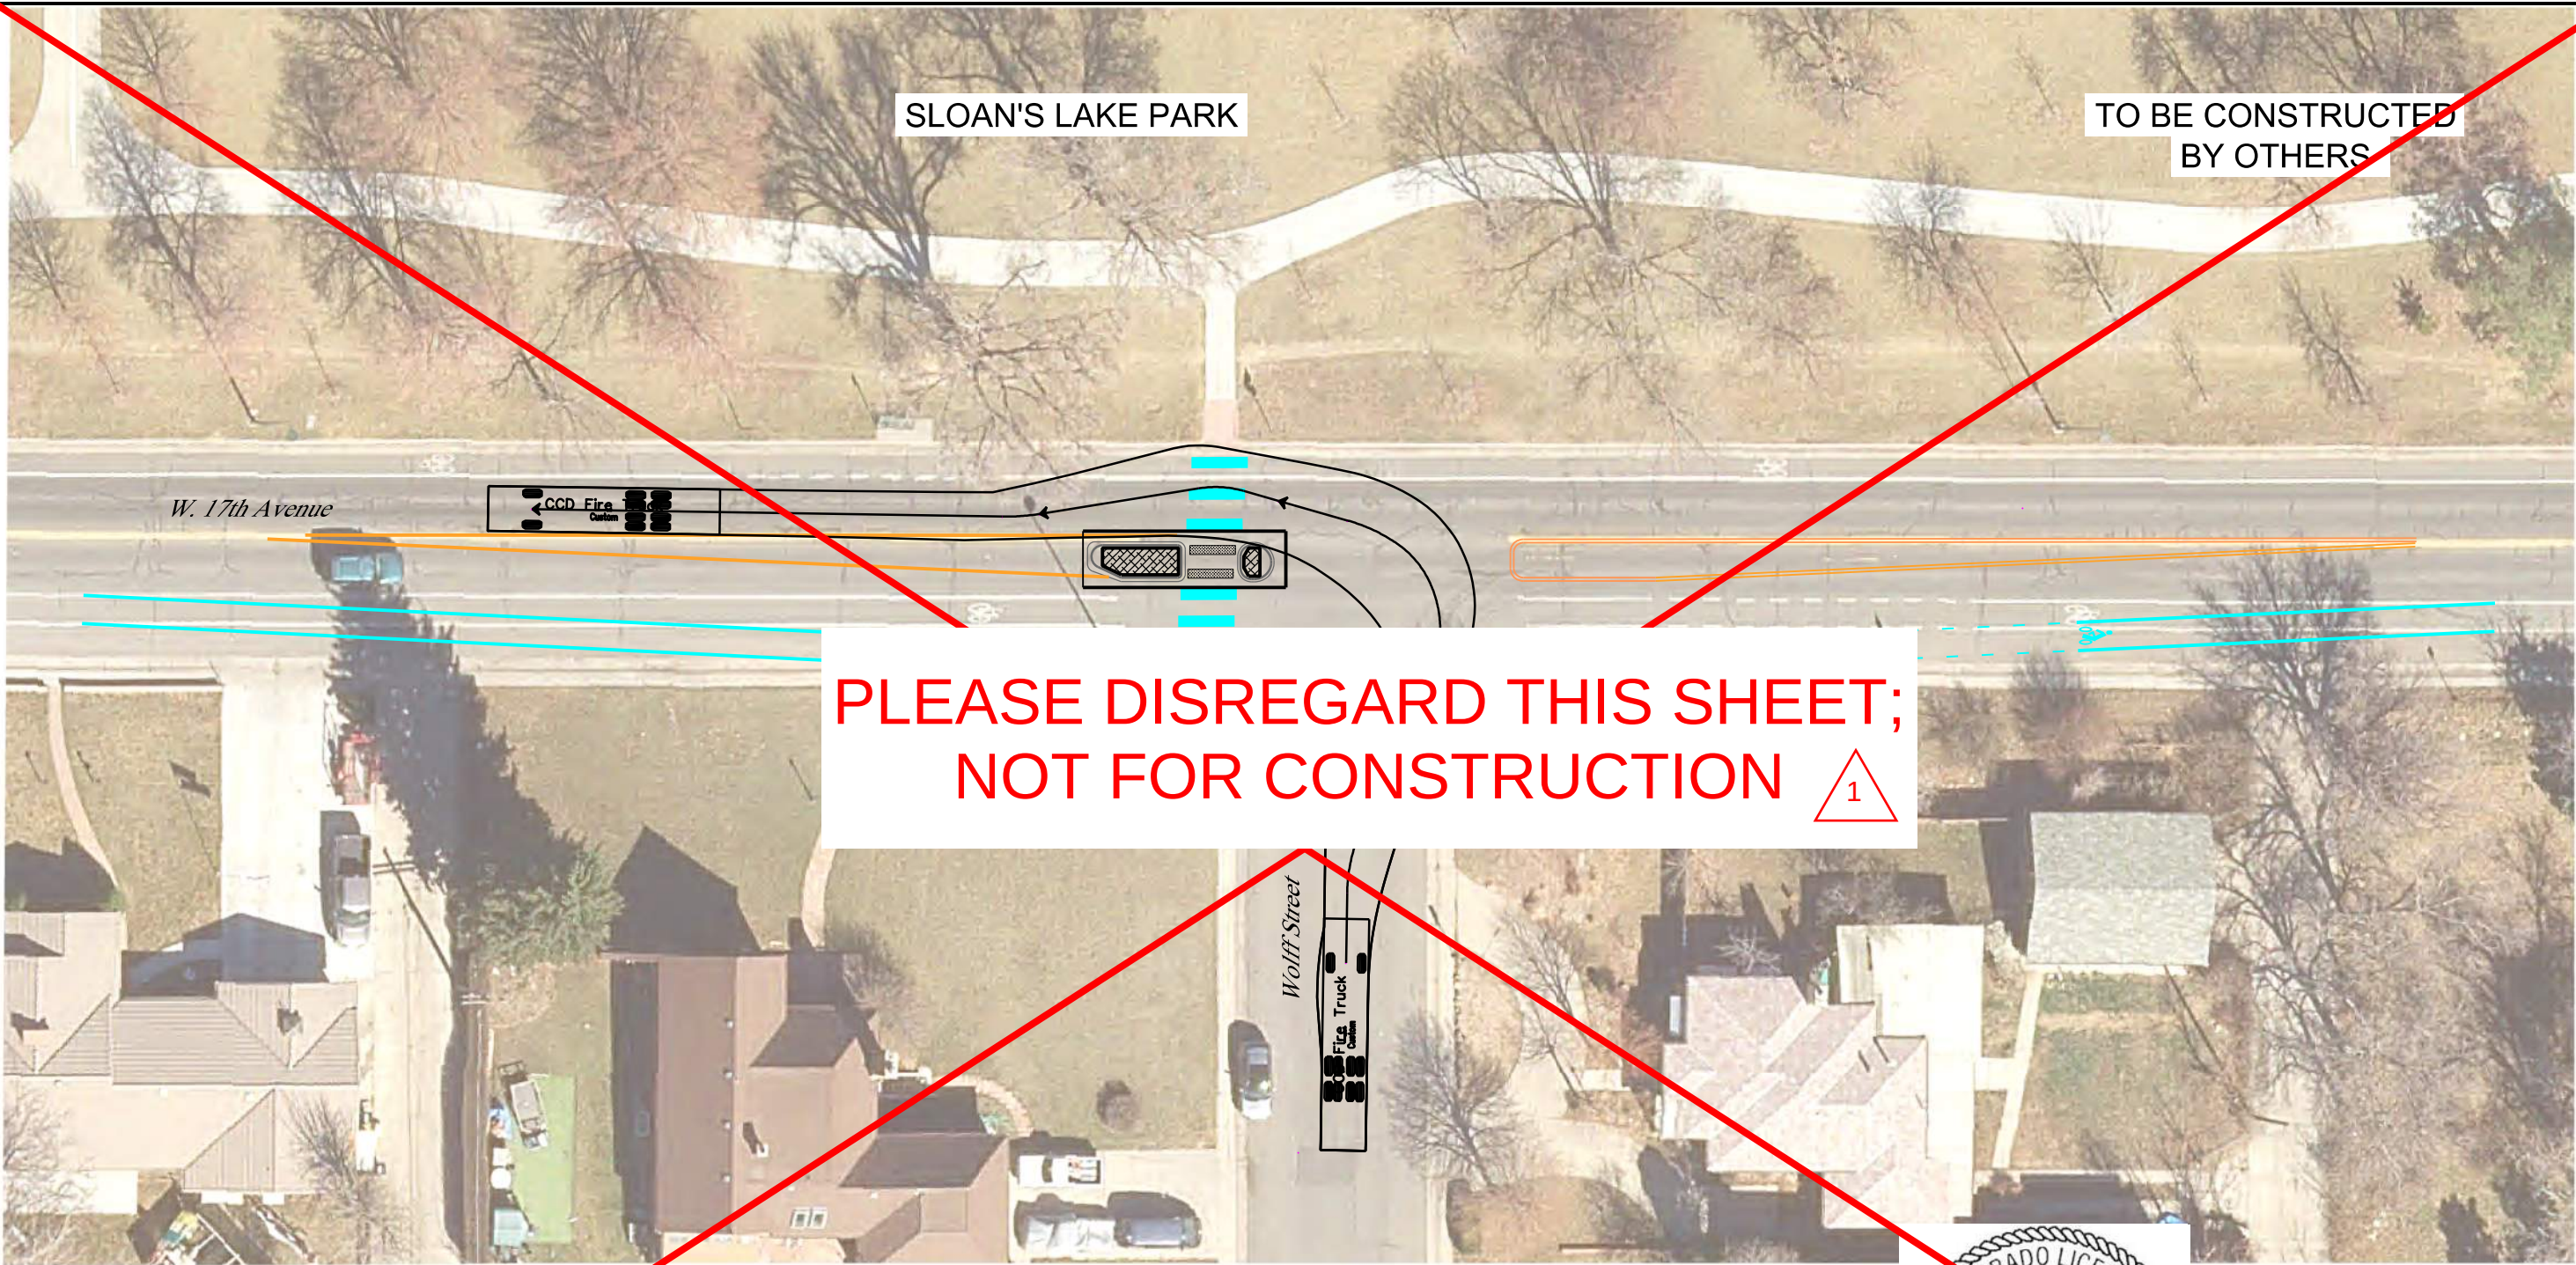

Print Date: 7/18/2022
Drawing File Name: 20005_SS4TRAF_Ped_Wolff Truck Turning Template.dgn
Horiz. Scale: 1:30 Vert. Scale: As Noted



0000

Sheet Revisions		
Date:	Comments	Init.



As Constructed

No Revisions:

Revised:

Void:

WOLFF STREET & W.17TH AVENUE
CCD FIRE TRUCK TURNING TEMPLATE


Designer:	AJL	Structure Numbers	
Detailer:	REW		
Sheet Subset:	WOLFF	Subset Sheets:	4 of 4

Sheet Number


21

slition 12/28/15 PM, P:\2020 Projects\2005.01 Ped Intersection Program Development\2005\Traffic_ITS\Drawings\Alameda-Mississippi-Cosage-Wolff Plan Package\2005_SS4TRAF_Details.dgn
6/6/2022 C:\DOT-Default\Printer_V8.plt MEC-Standard.ctb

HARDENED CENTERLINE DETAIL:

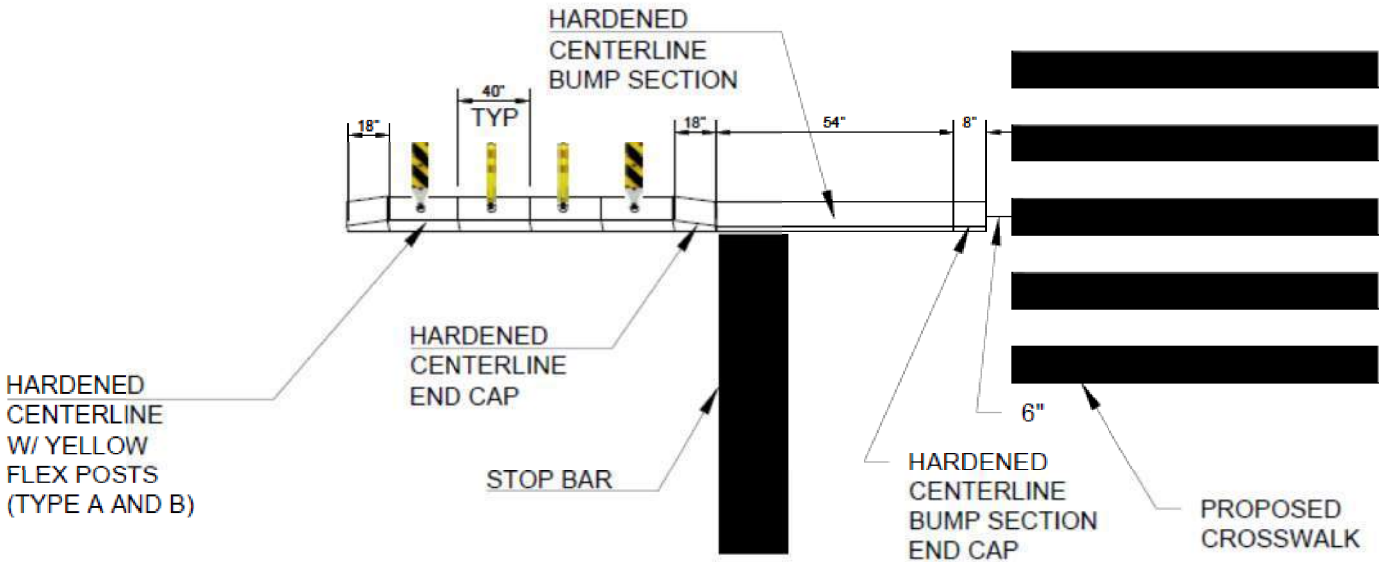


HARDENED CENTERLINE WITH FLEXIBLE POSTS SPECIFICATIONS:

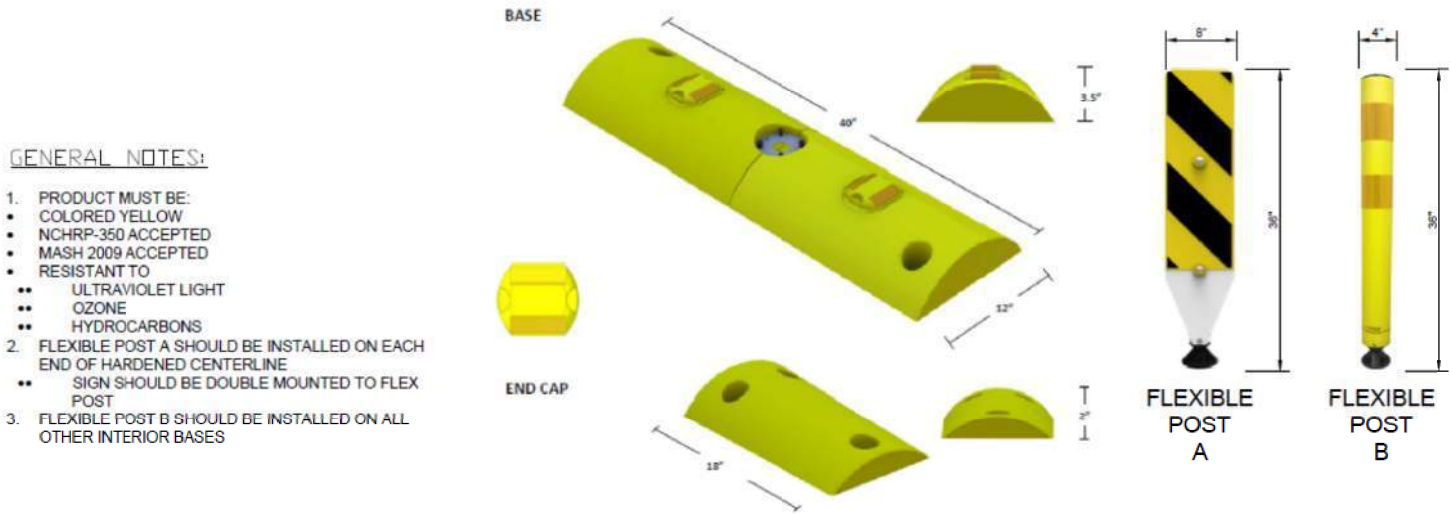


Detail added for 6" curb head, to be used for asphalt median border.

CITY POST SURFACE MOUNT DETAIL ("POST C"):

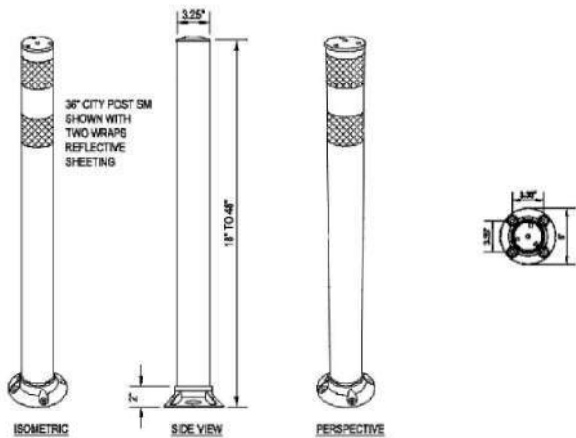

- NOTES:**
1. INSTALLATION TO BE COMPLETED IN ACCORDANCE WITH MANUFACTURER'S SPECIFICATIONS.
 2. DO NOT SCALE DRAWING.
 3. FLUORESCENT COLORS ARE RECOMMENDED FOR APPLICATIONS REQUIRING THE HIGHEST VISIBILITY.
 4. WHITE CITY POSTS SHALL BE PEXCO CITY POST, SURFACE MOUNT (SM) MODEL OR APPROVED EQUAL.
 5. CITY POSTS WILL BE 36".
 6. POSTS MAYBE BE ORDERED W/FACTORY APPLIED, HIGH INTENSITY OR PRISMATIC SUPER HIGH INTENSITY RETRO-REFLECTIVE SHEETING. SPECIFY TYPE, COLOR AND SIZE WHEN ORDERING. USE 3M FLEX DIAMOND GRADE REFLECTING SHEETING.
 7. CONTRACTOR'S NOTE: FOR PRODUCT AND COMPANY INFORMATION VISIT WWW.CADSTANDARDS.COM/INFO AND ENTER REFERENCE NUMBER 644-069.

HARDENED CENTERLINE BUMP SPECIFICATIONS:

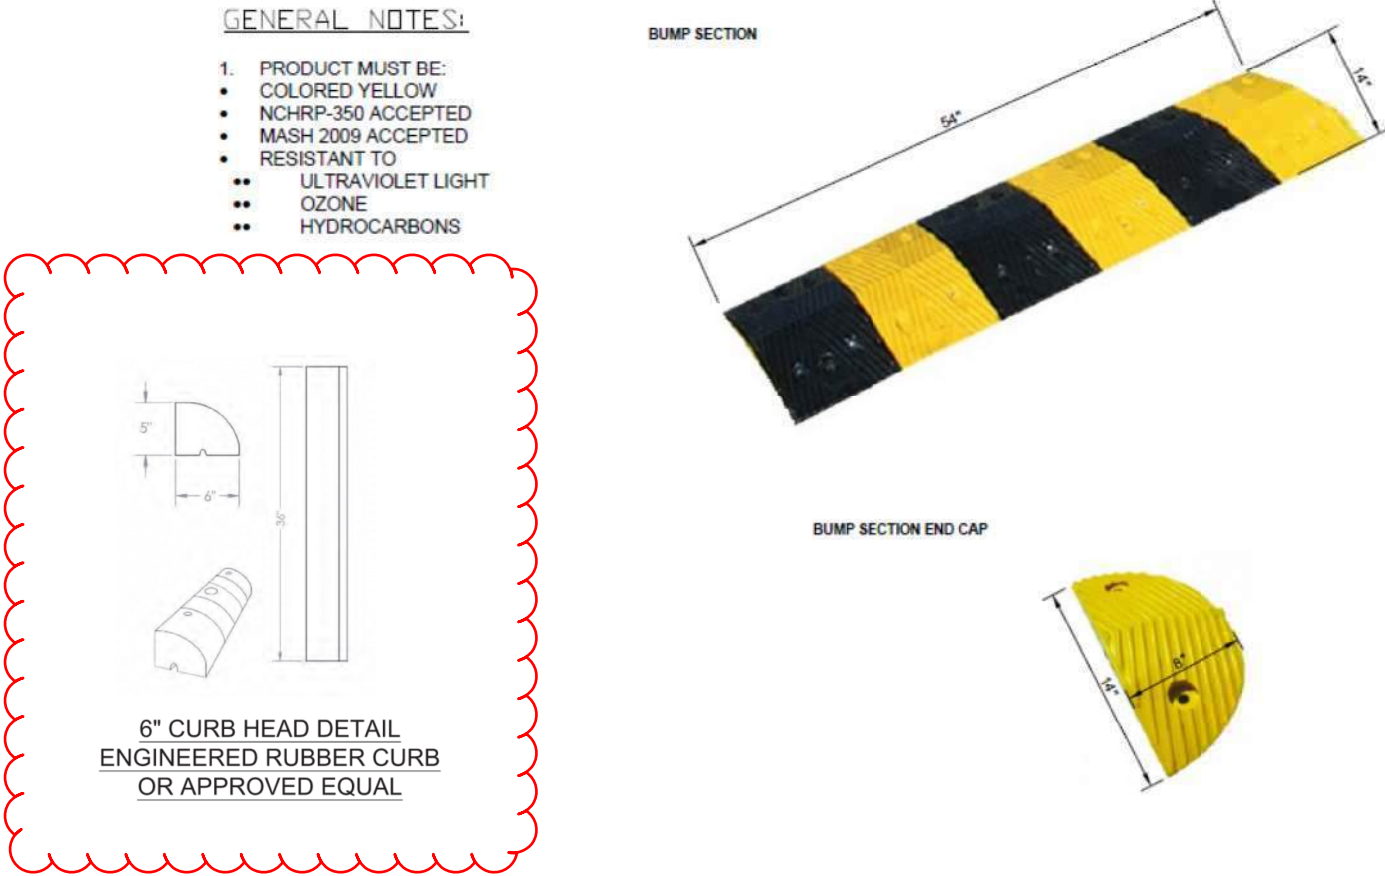

Print Date: 6/6/2022

Drawing File Name: 20005_SS4TRAF_Details.dgn

Horiz. Scale: 1:1 Vert. Scale: As Noted


MULLER
ENGINEERING COMPANY

Sheet Revisions			
Date:	Comments	Init.	




As Constructed		DETAIL SHEET			
No Revisions:					
Revised:	Designer:	AJL	Structure Numbers	Sheet Number	
	Detailer:	MAB			
Void:	Sheet Subset:	DETAIL	Subset Sheets:	1 of 3	22

3' LONG RUBBERIZED PARKING BLOCKS FOR MEDIAN

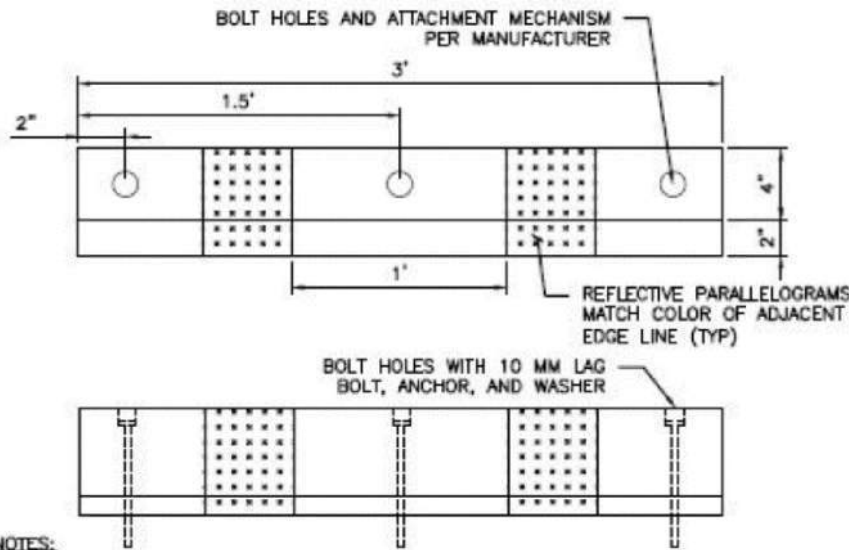


- NOTES:**
- PRODUCT MUST BE:
 - TYPICAL DIMENSIONS
 - 3 FEET LONG.
 - 6 INCH HEIGHT
 - 6 INCH WIDTH
 - BLACK RUBBER WITH YELLOW REFLECTIVE MARKINGS.
 - RESISTANT TO:
 - ULTRAVIOLET LIGHT
 - OZONE
 - HYDROCARBONS
 - PRODUCT SHALL BE INSTALLED PER MANUFACTURER RECOMMENDATIONS WITH ASPHALT ANCHORS.

CONCRETE/CRUSHER FINE TRAIL INTERSECTION

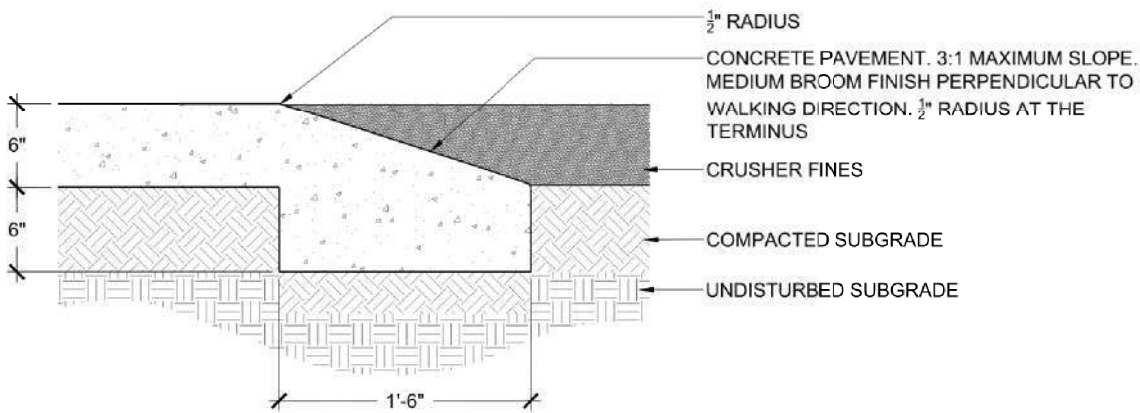


- NOTE:**
- REFER TO SPECIFICATIONS FOR ALL MATERIALS CALLED OUT IN DETAIL.

GEAR DRIVE ROTOR

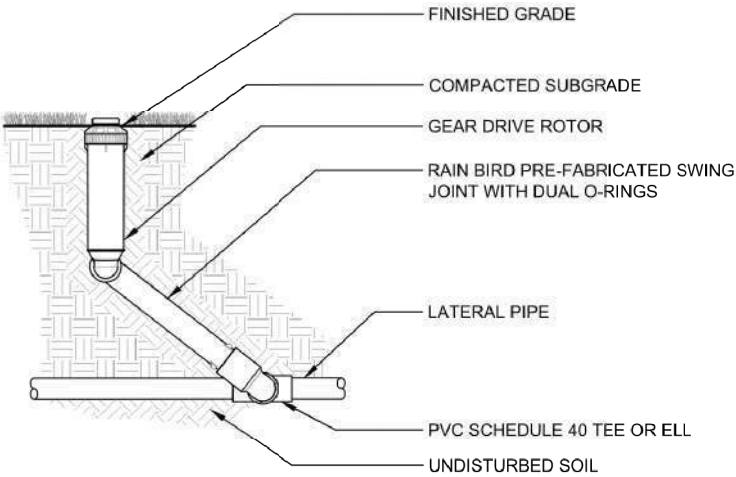


CONCRETE PAVEMENT

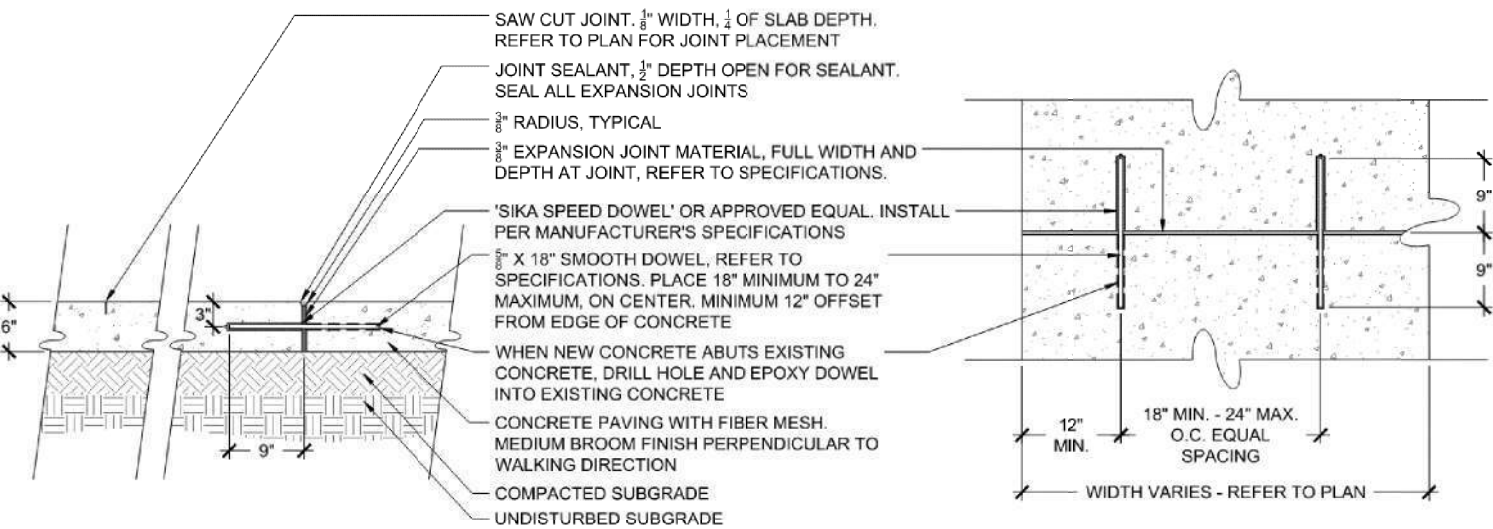

- NOTES:**
- REFER TO SPECIFICATIONS FOR ALL MATERIALS CALLED OUT IN DETAILS.
 - LOCATE EXPANSION JOINTS EVERY 200' MAXIMUM, OR AS SHOWN ON THE PLAN.

IRRIGATION SLEEVE

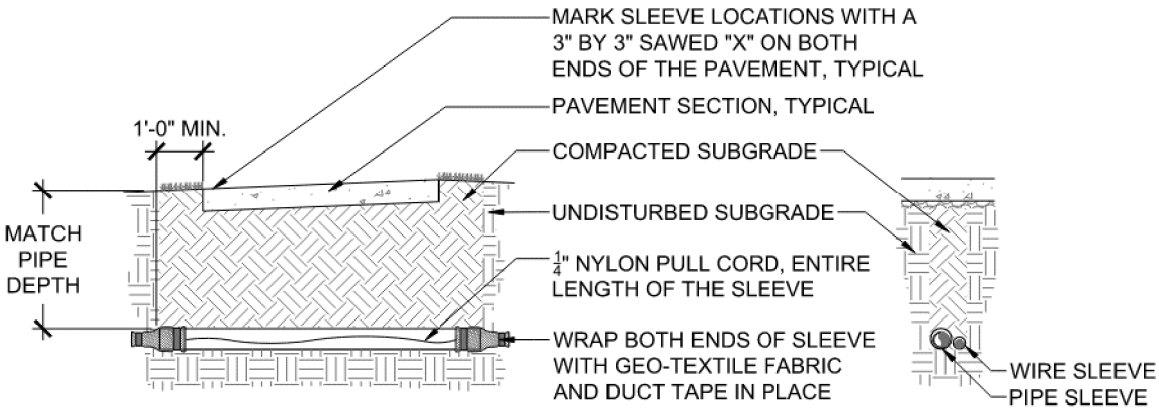

- NOTES:**
- REFER TO SPECIFICATIONS FOR ALL PRODUCTS AND MATERIALS.
 - ALL MAINLINE SLEEVES HAVE A SEPARATE COMPANION SLEEVE FOR WIRE, PLACED SIDE BY SIDE.
 - MULTIPLE SLEEVES INSTALLED ADJACENT TO ONE ANOTHER ARE TO BE PLACED SIDE BY SIDE, NEVER STACKED.
 - WATER SETTLING OF TRENCHES UNDER PAVEMENT IS NOT PERMITTED.

Print Date: 6/6/2022
Drawing File Name: 20005_SS4TRAF_Details.dgn
Horiz. Scale: 1:1
Vert. Scale: As Noted



Sheet Revisions			
Date:	Comments	Init.	



As Constructed

No Revisions:

Revised:

Void:

DETAIL SHEET

Designer:

AJL

Detailer:

MAB

Sheet Subset:

DETAIL

Structure

Numbers

Subset Sheets:


2 of 3

Sheet Number

23

\\s01n12\1010 PM 6/6/2022 Projects\2005\05.01 Ped Intersection Program Development\2005\Traffic_ITS\Drawings\Alameda-Mississippi-Osage-Wolff Plan Package\2005_SS4TRAF_Details.dgn
CDOT-DefaultPrinter_V8.plt MEC-Standard.tbl

POP-UP SPRAY HEAD

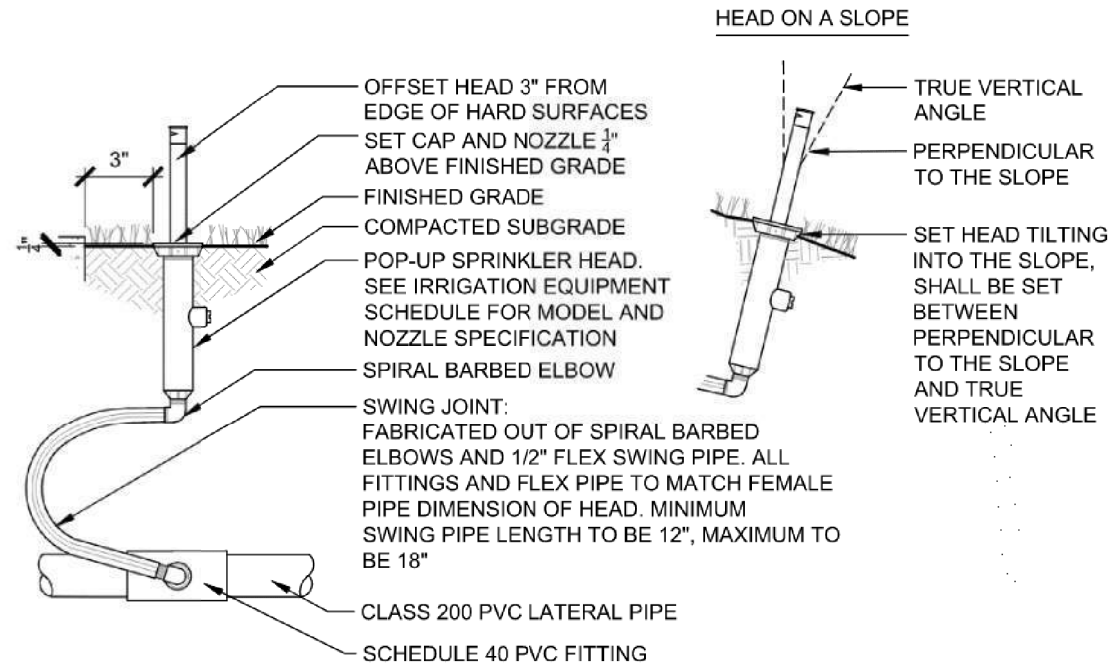

- NOTES:
1. PLUMB HEAD PERPENDICULAR TO FINISHED GRADE OR AS SPECIFIED FOR HEADS ON A SLOPE.
 2. REFER TO SPECIFICATIONS FOR ALL MATERIALS CALLED OUT IN DETAIL.



Print Date: 6/6/2022			Sheet Revisions			DENVER TRANSPORTATION & INFRASTRUCTURE	As Constructed	DETAIL SHEET				
Drawing File Name: 20005_SS4TRAF_Details.dgn			Date:	Comments	Init.		No Revisions:					
Horiz. Scale: 1:1							Revised:	Designer: AJL	Structure Numbers	Sheet Number		
Vert. Scale: As Noted							Void:	Detailer: MAB				
MULLER ENGINEERING COMPANY							Sheet Subset: DETAIL	Subset Sheets: 3 of 3				24